


38'
DESIGN

The Temagami / Elev. A & B

Includes 760 sq. ft. of finished area in lower level


delete
replace

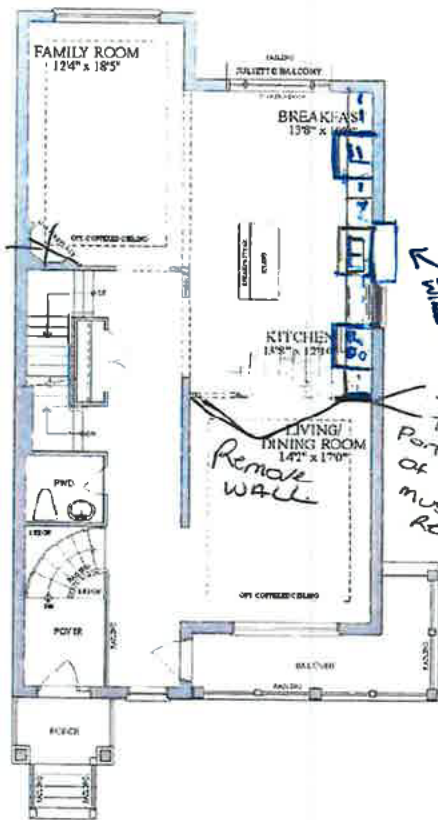


FIRST FLOOR
ELEVATION A & B



SECOND FLOOR
ELEVATION A

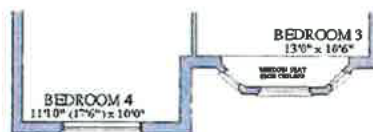

SECOND FLOOR
ELEVATION B

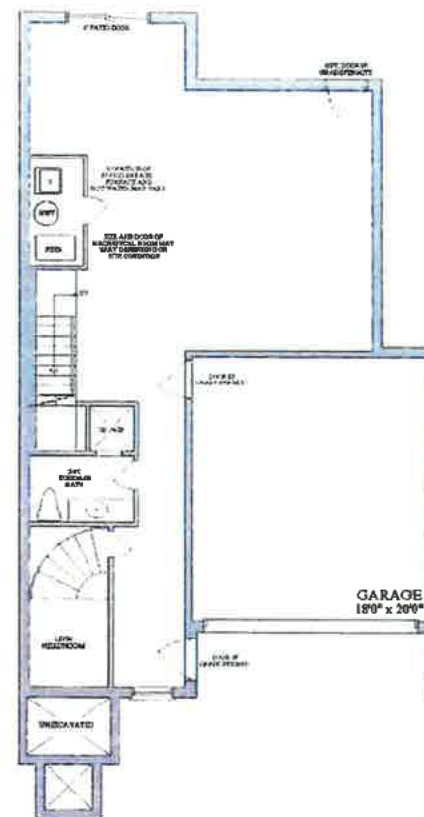

LOWER LEVEL
ELEVATION A & B
2 CAR GARAGE
3350 SQ. FT. INCLUDES 760 SQ. FT.
OF FINISHED AREA IN LOWER LEVEL



Plans and specifications are subject to change without notice. E. & O. E. Actual construction may vary from the submitted plans. All measurements are given in feet and inches.

LOT 5-73, PE003, SKETCH

Purchaser Onel Khosho (Sep 30, 2021 15:47 EDT)