



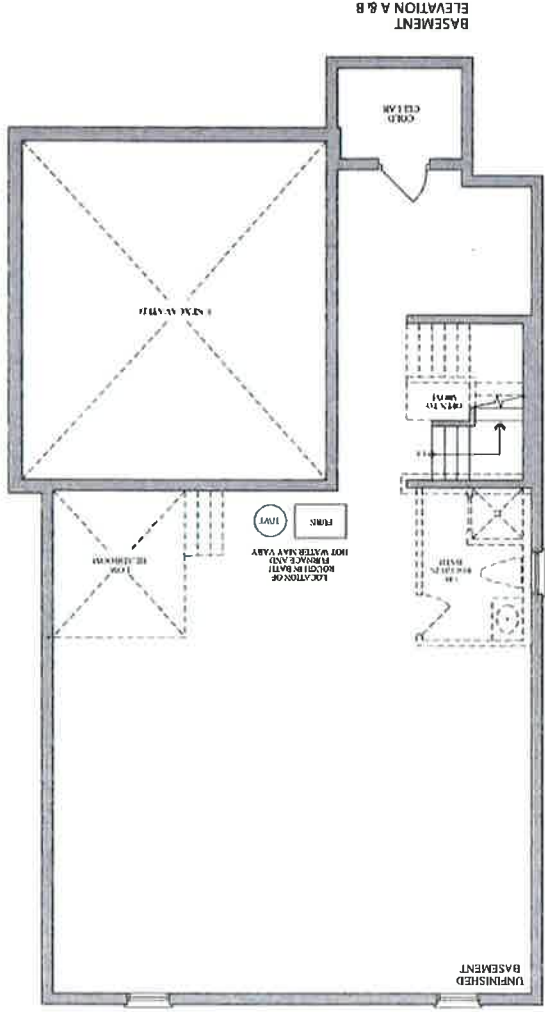

LOT 5-78, PE002

PURCHASER: Narinder Manihani (Aug 25, 2021 15:30 EDT)

Mark

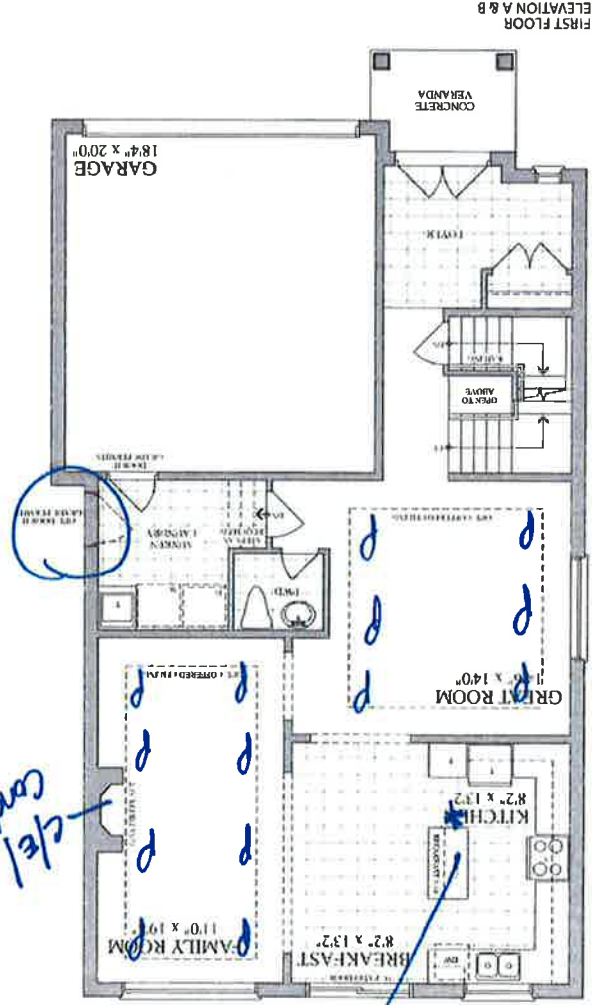