
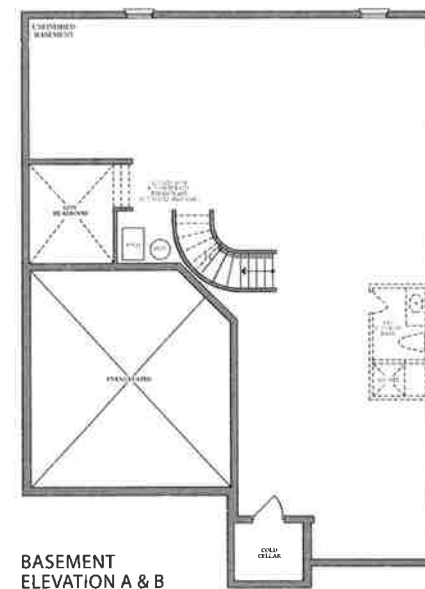
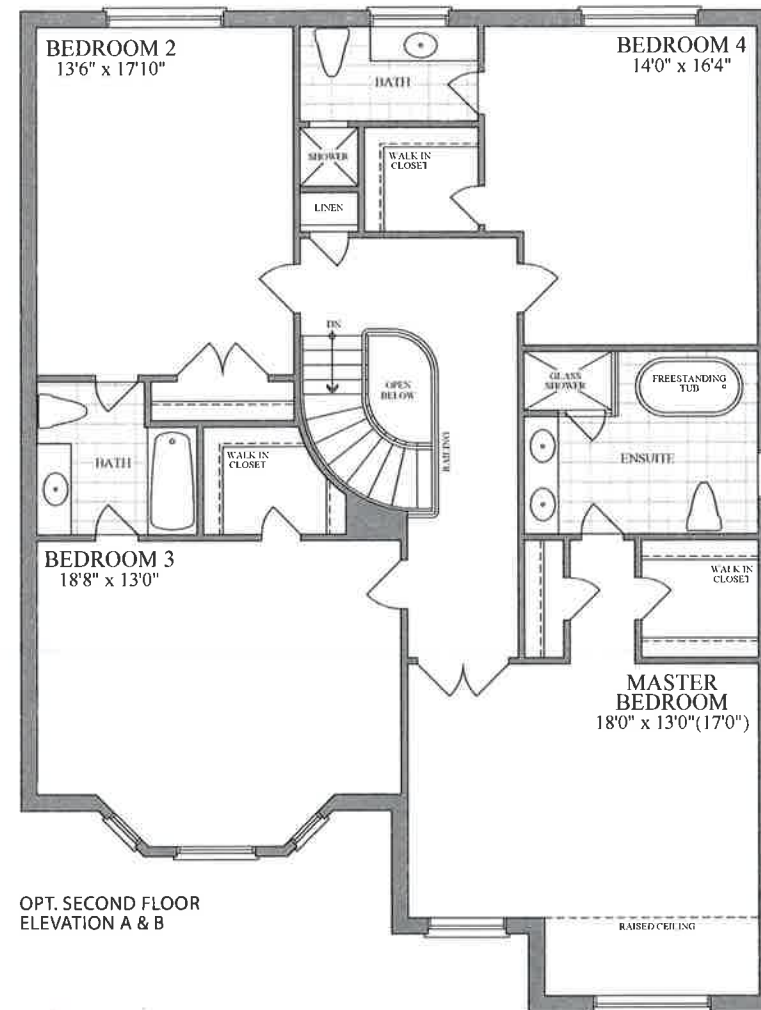
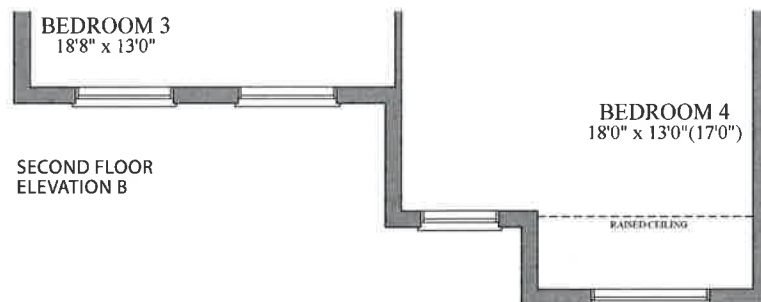
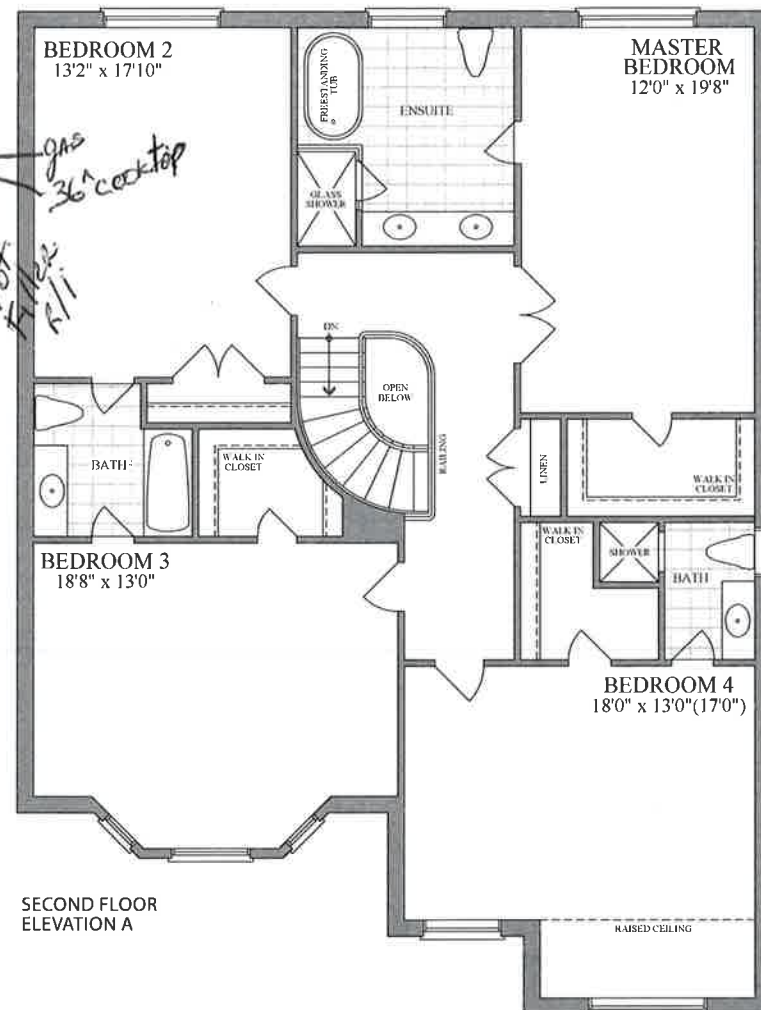


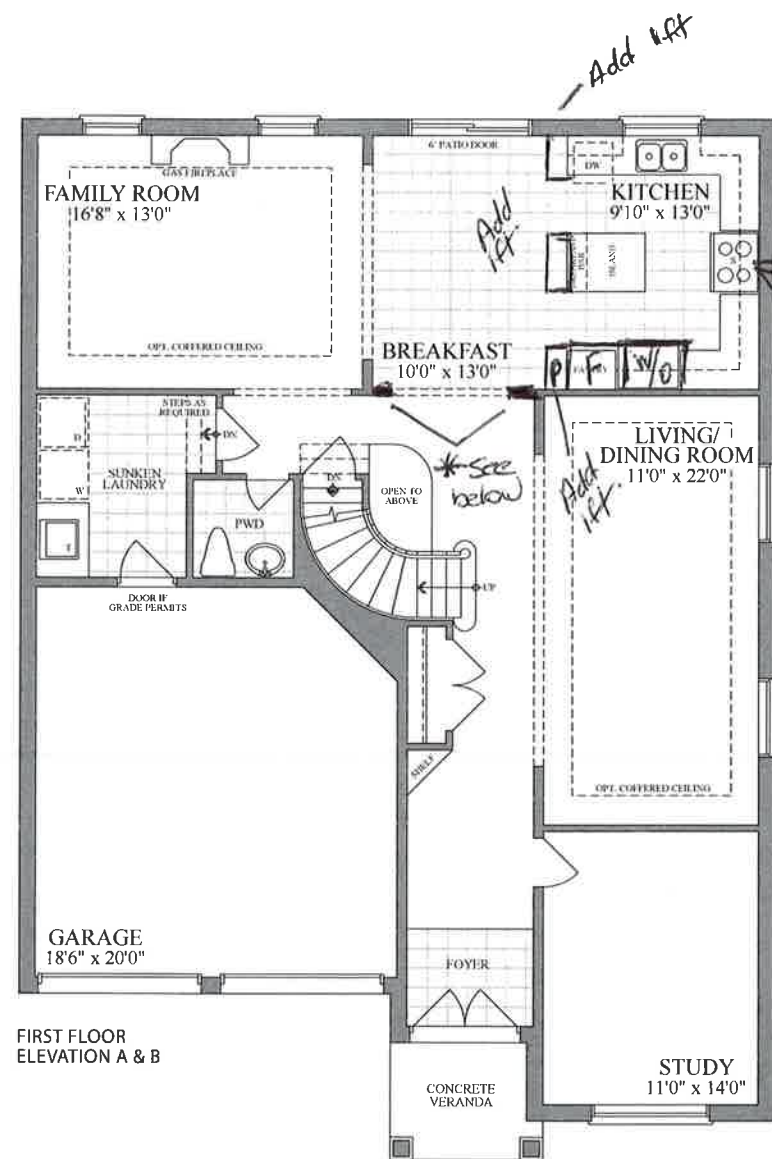

* We need to extend this wall so that we can get extra room for the built-in appliances

LOT 5-80
PE #002

Handwritten signature/initials.

Handwritten signature/initials.