



Lot 5-90 PE#003

INCREASE
SHOWER BY
1 FOOT.

DECREASE
MASTER BY
1 FOOT
RE Center
Window

38'
designs

The Buckhorn / Elev. A & B
1800 sq.ft.

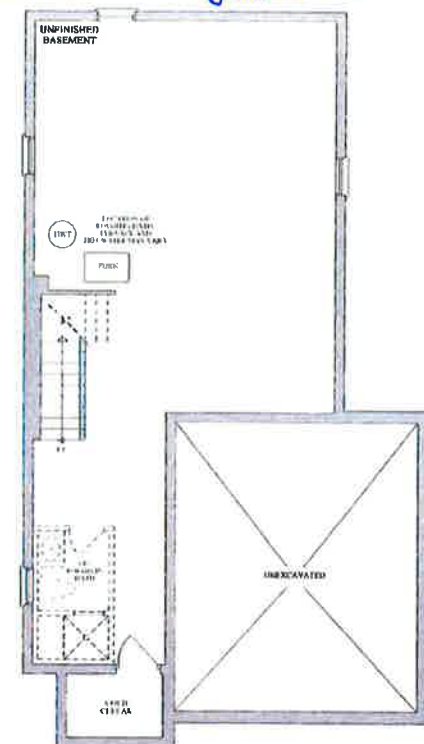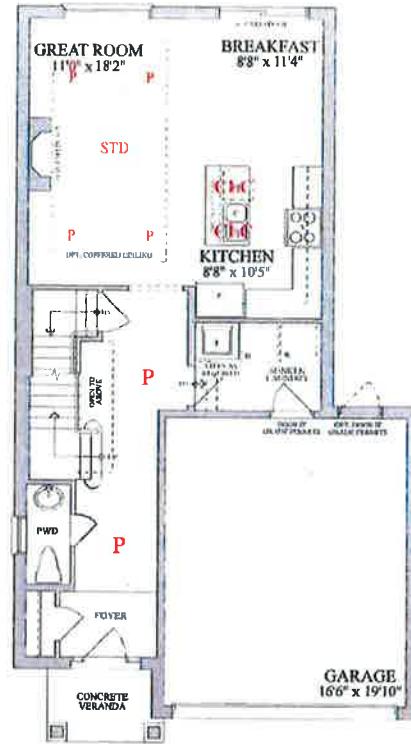

LOT 5-90, PH5, PE002, SKETCH

PURCHASER: Kevin Strydom (14, 2021 13:16 MDI)



Plans and specifications are subject to change without notice. 1 & O. E. Actual results may vary from the stated floor area. All measurements are in feet and inches.