



38'
DESIGNS

The Fraser / Elev. A & B
2250 sq.ft.


8' Vest
Fridge Enclosure
Pantry

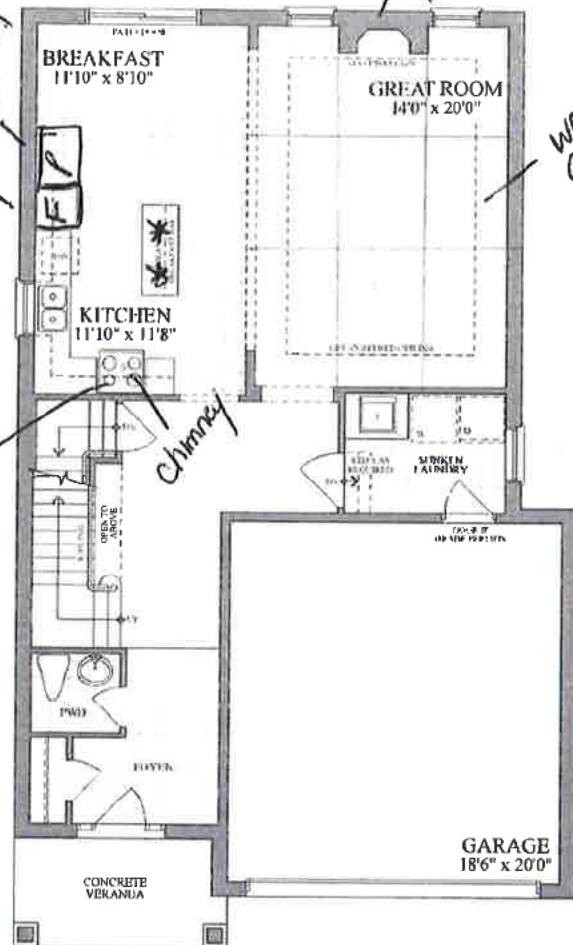


FIRST FLOOR
ELEVATION A & B

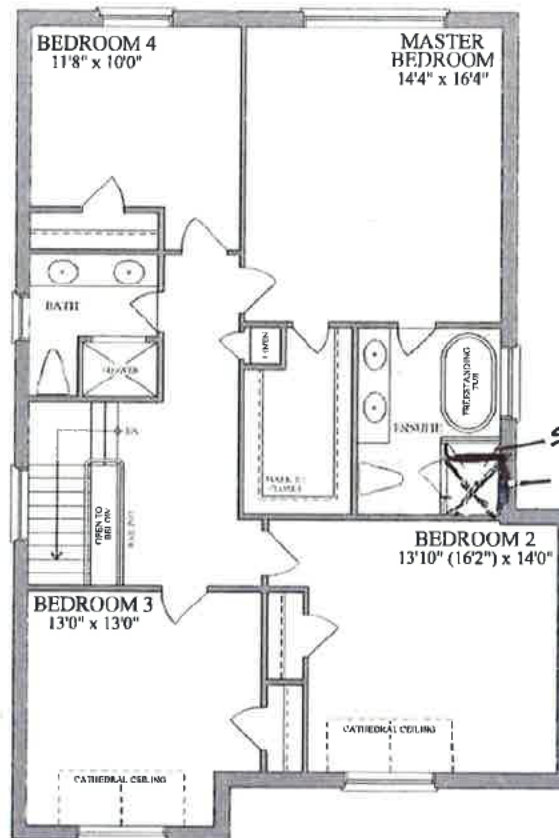

SECOND FLOOR
ELEVATION A

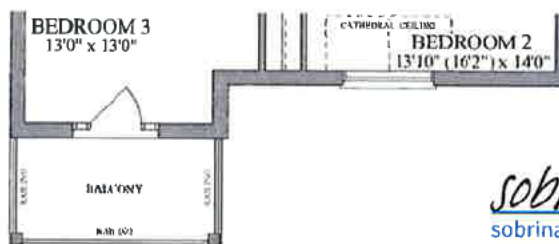

SECOND FLOOR
ELEVATION B

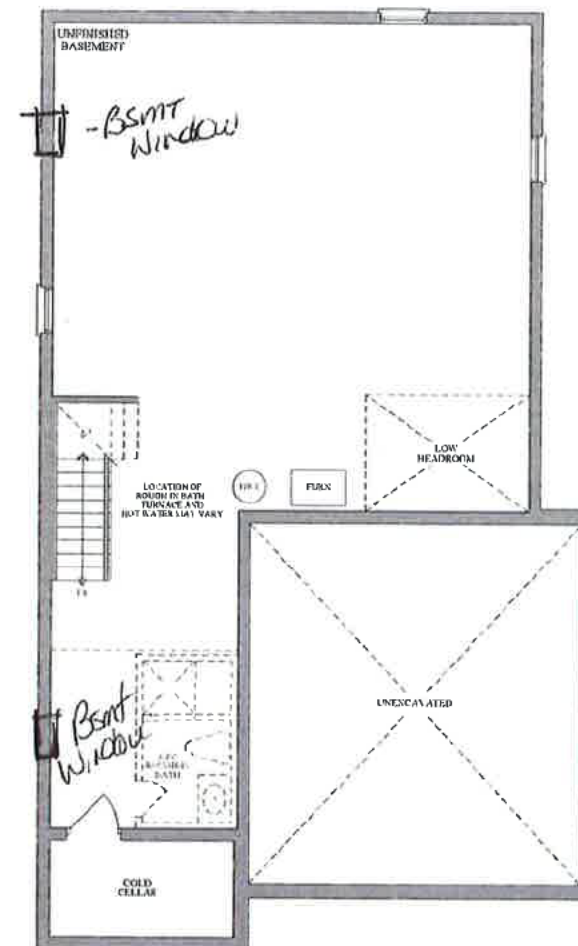

BASEMENT
ELEVATION A & B



sobrina akosua adjei

sobrina akosua adjei (Nov 29, 2021 12:10 EST)

B. Seriki

bode seriki (Nov 22, 2021 09:46 EST)



Plans and specifications are subject to change without notice. E. & O. E. Actual usable floor space may vary from the stated floor area. All renderings are artist's concept.