
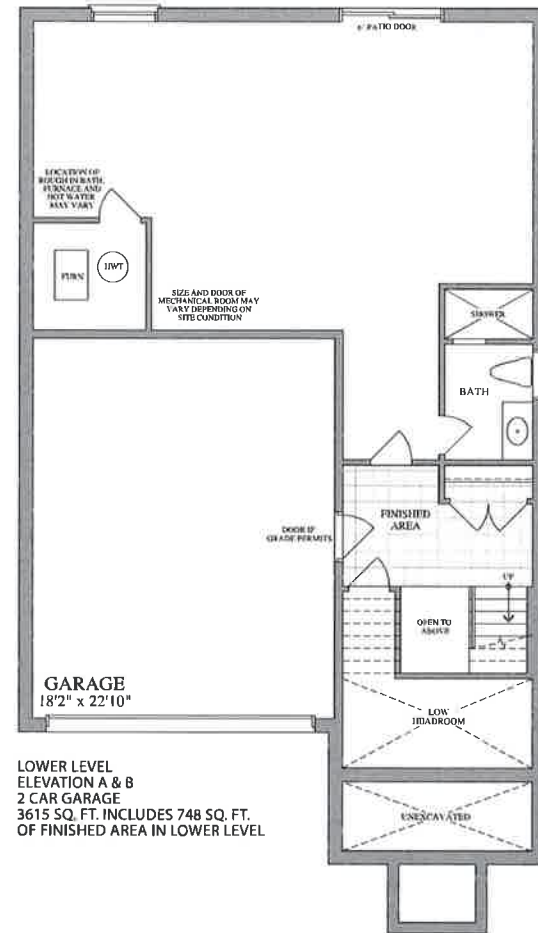
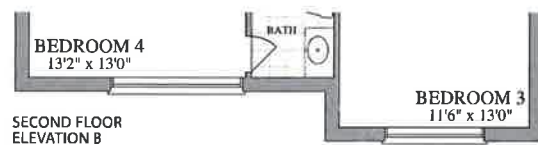


38'
DESIGNS

The Superior / Elev. A & B
includes 748 sq. ft. of finished area in lower level

centered.
/

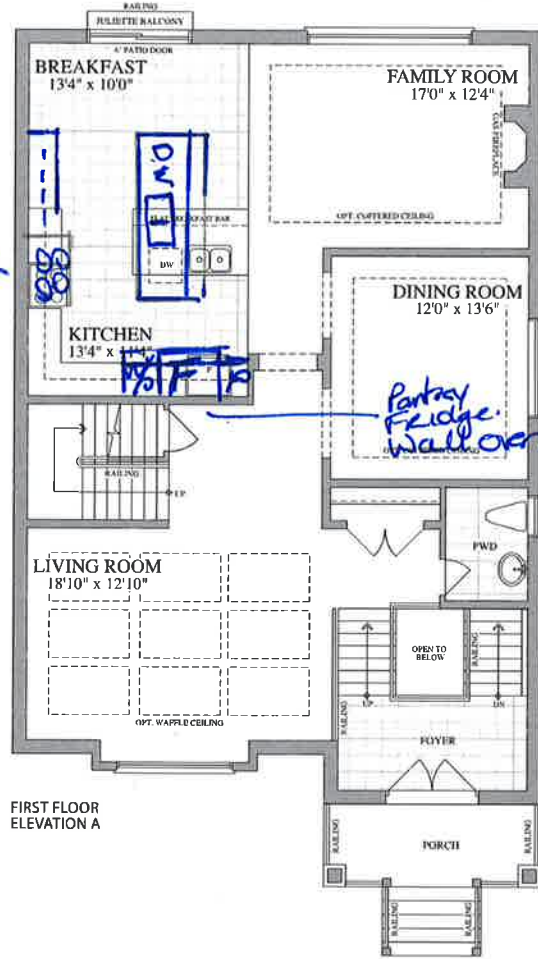

LOT 5-54, PH5, INNISFIL, PE002 AND PE003

Purchaser: Darlene Johnson
Darlene Johnson (Nov 10, 2021 14:40 EST)

Purchaser: _____



Plans and specifications are subject to change without notice, E. & O. E. Actual usable floor space may vary from the slated floor area. All renderings are artist's concept.