



LORMEL DEVELOPMENTS (BRADFORD) LTD.
PURCHASER EXTRAS

PART # 015 P.E #002 — Model - ROSEMOUNT - 2800

Attention Trades...

The following items below are Purchaser Extras, please make sure that they are done on time and properly complete. Any outstanding items will be Back Charged. If you have any questions please call Roberto Ruiz. Make sure that you review ALL of the items on the Purchaser Extras.

Please be advised that Purchase Orders will come at a later date.

*****Also, it is very important to speak to Roberto Ruiz before starting on site ****

TRADE:		ITEMS TO BE COMPLETED
Miranda Painting	#1	
Liberty	#2, #4	
North York Tile	#3	

Date: Jun.-08-2021
From: Lormel Homes
Site Clerk: Jai Fitzgerald
Site Tel: 905-775-3633
Site Fax: 905-775-9083

NOTE: If more information is needed please call Roberto Ruiz cell-416-688-9324
If more information needed on quotes or changes, please call Zachary 905-832-2023 ext. 224

Part 015, Ph 3.


PE002

(Bradford)


SCHEDULE F
Floor Plan Rosemount 2800 Elevation A
LOT Part 15, PHASE 3, PLAN 50M-1087

PURCHASER'S INITIAL I. C.


PURCHASER'S INITIAL _____

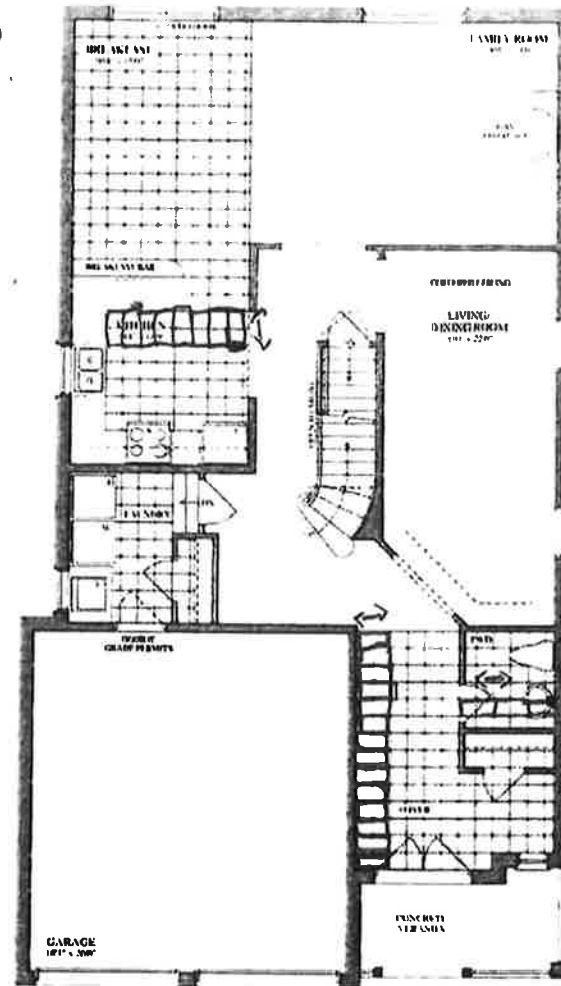


FIRST FLOOR
ELEVATION A, C

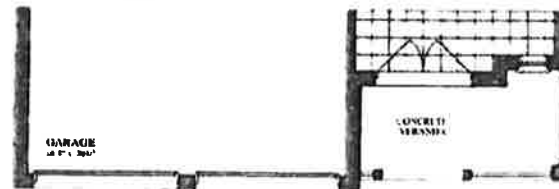


FIRST FLOOR
ELEVATION B

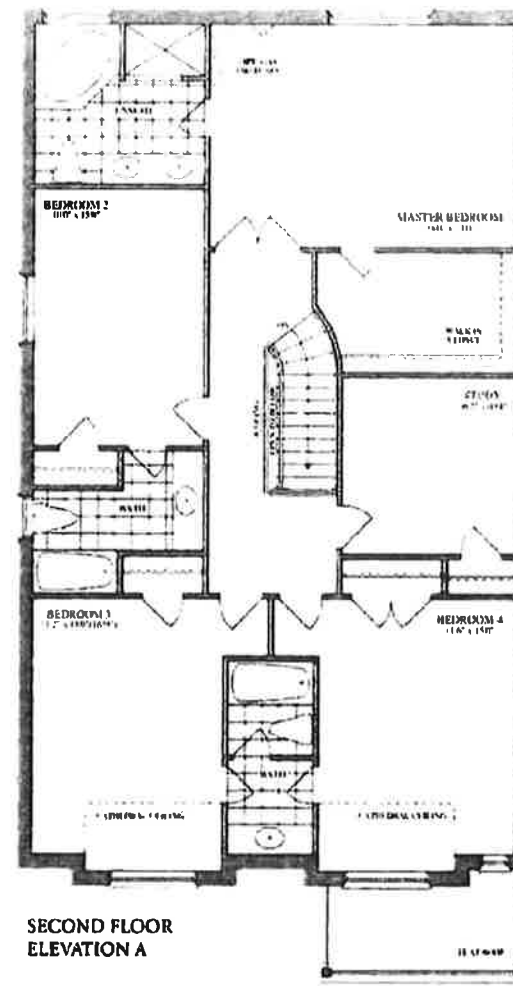


SECOND FLOOR
ELEVATION A

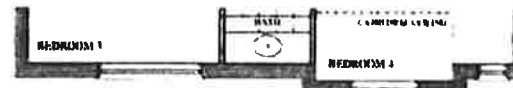

SECOND FLOOR
ELEVATION B

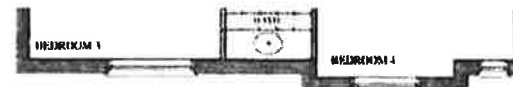

SECOND FLOOR
ELEVATION C

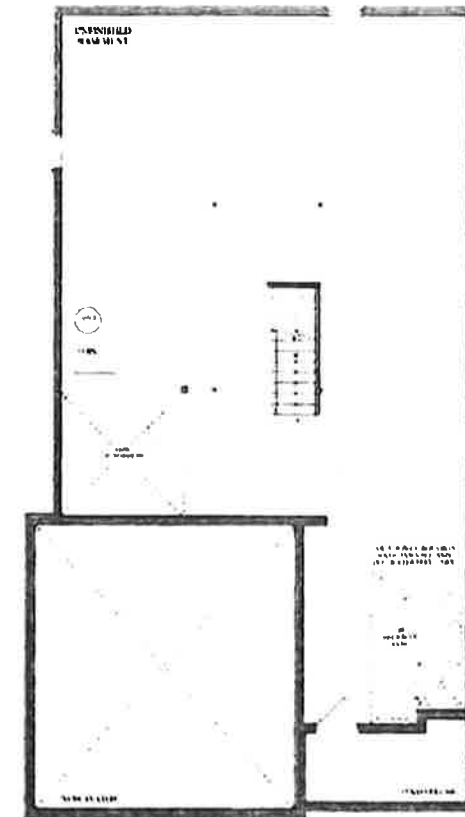

BASEMENT
ELEVATION A, B, C