


Part 015, Ph 3
 PE002
 (Bradford)

SCHEDULE F
 Floor Plan Rosemount 2000 Elevation A
 LOT Part 15, PHASE 3, PLAN EDM-1087

PURCHASER'S INITIAL


PURCHASER'S INITIAL

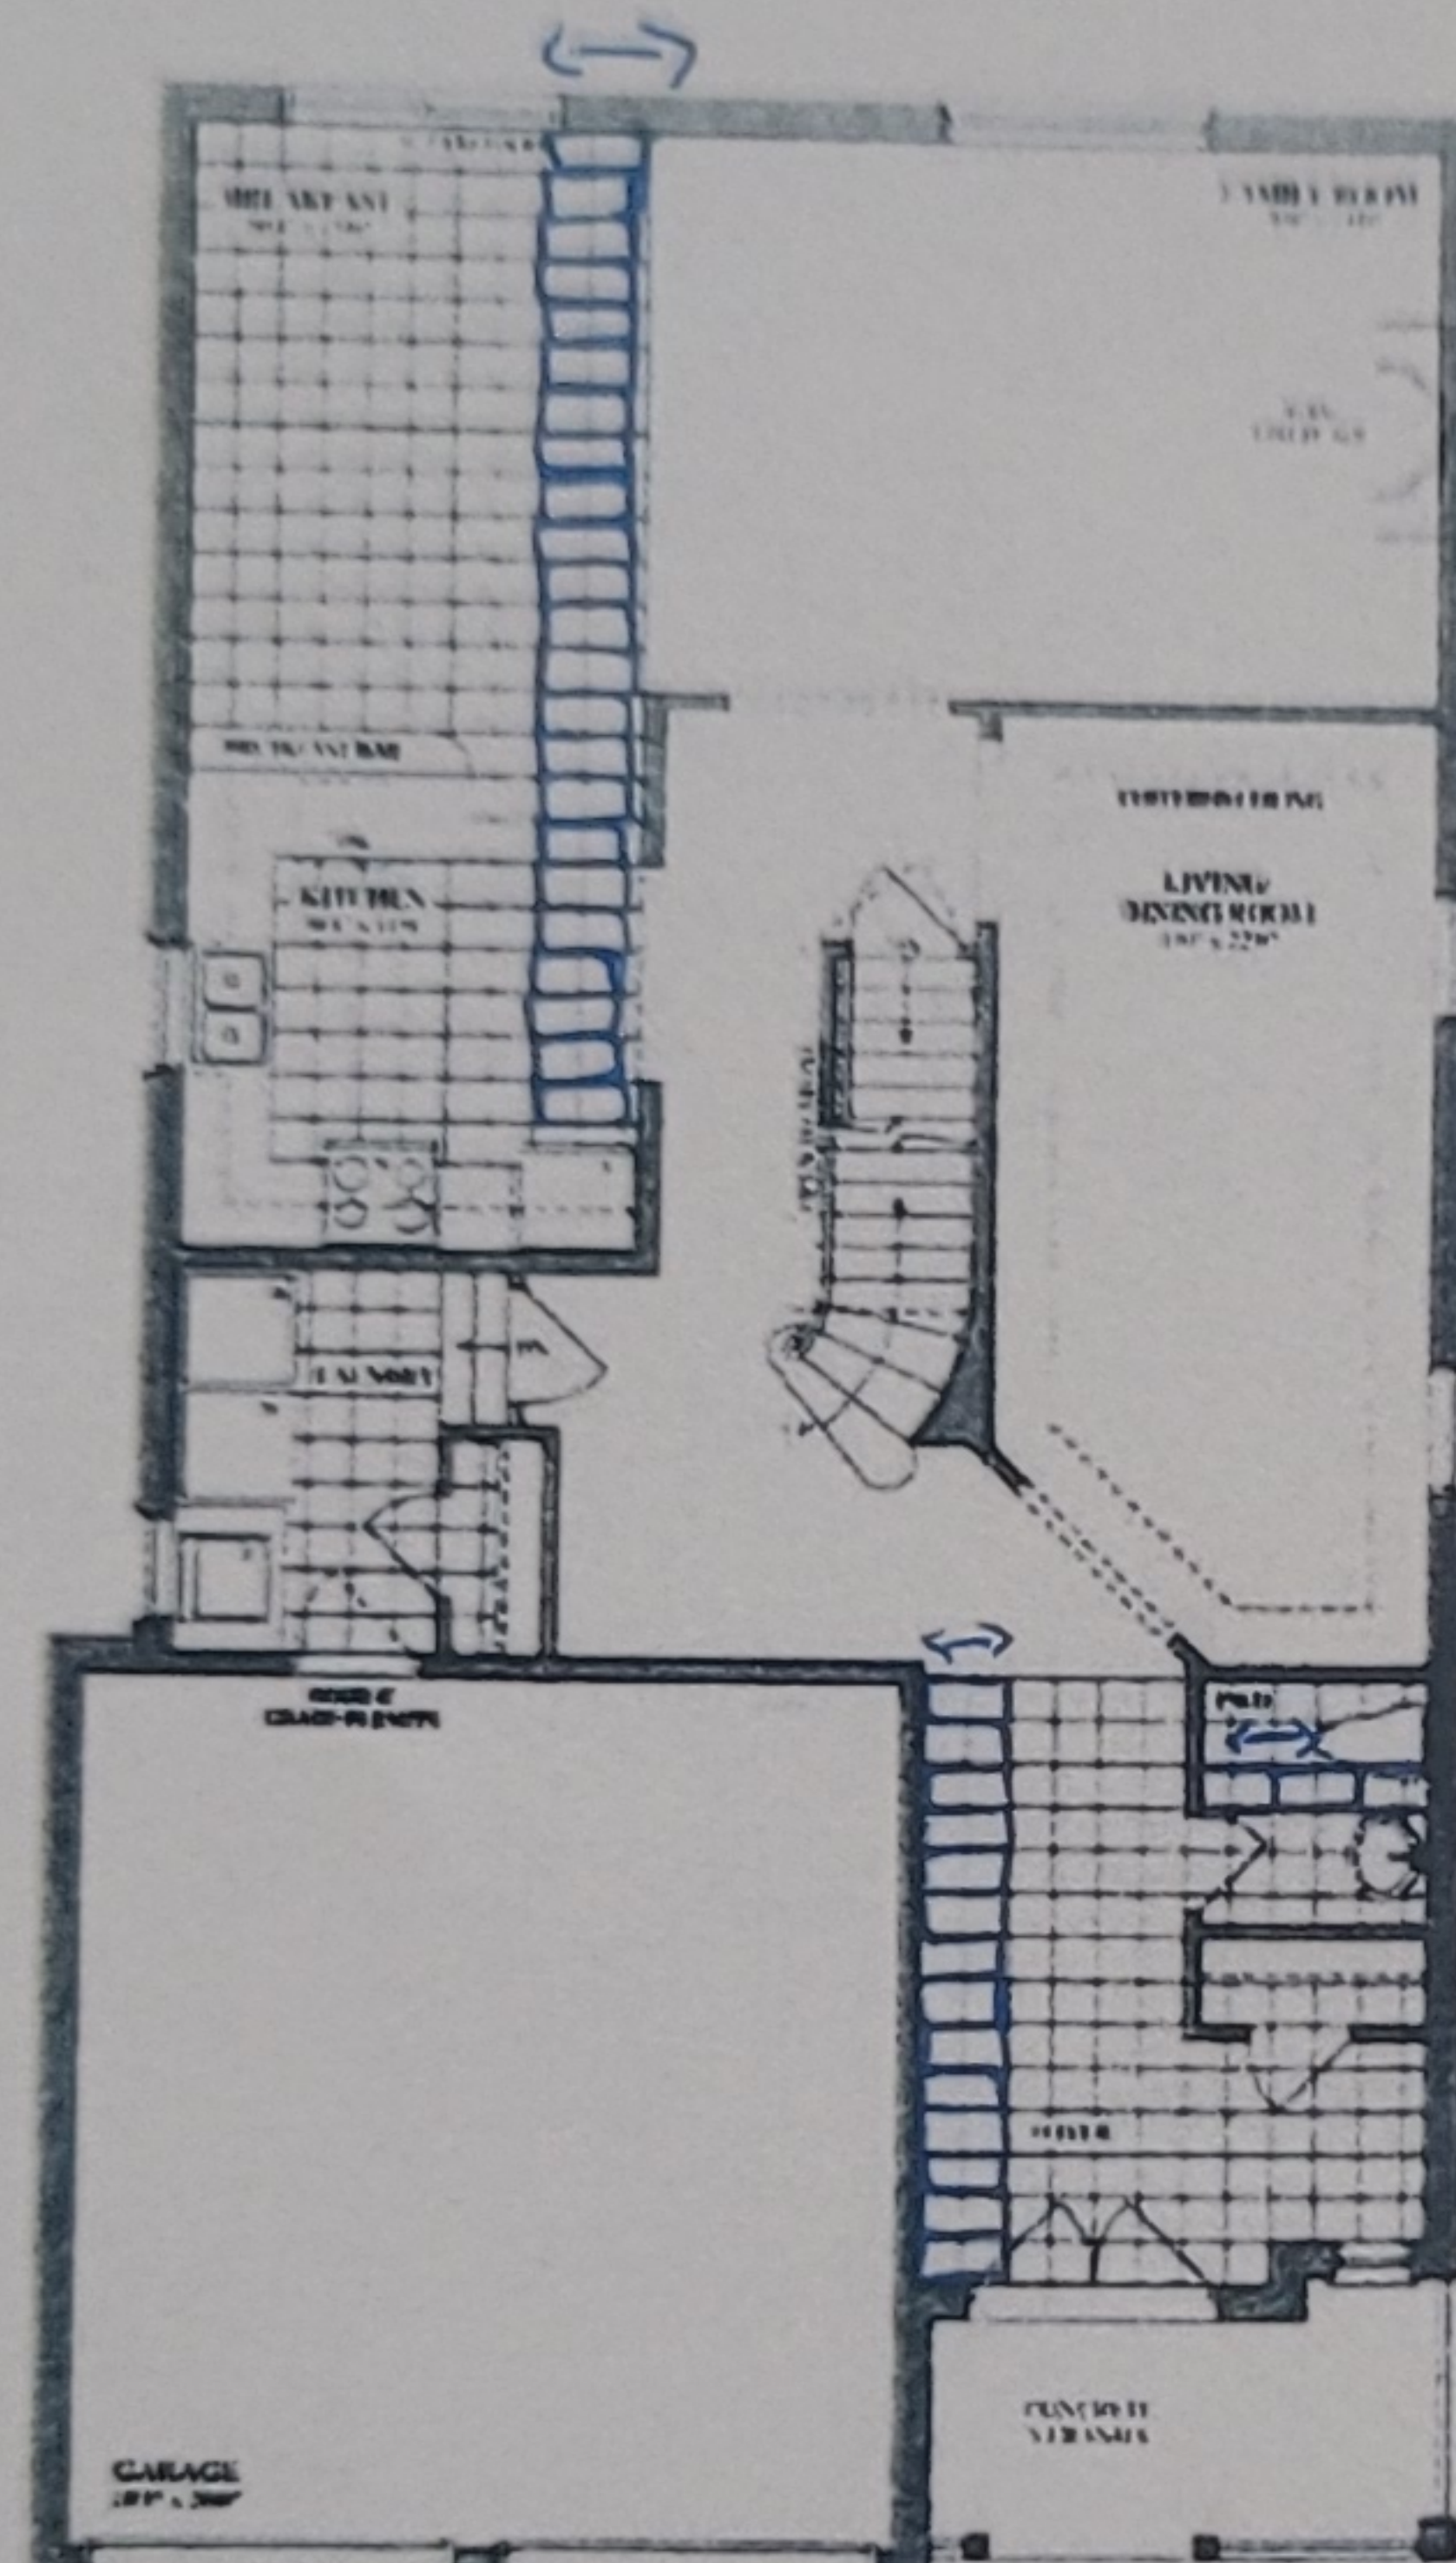


FIRST FLOOR
 ELEVATION A, C




FIRST FLOOR
 ELEVATION B

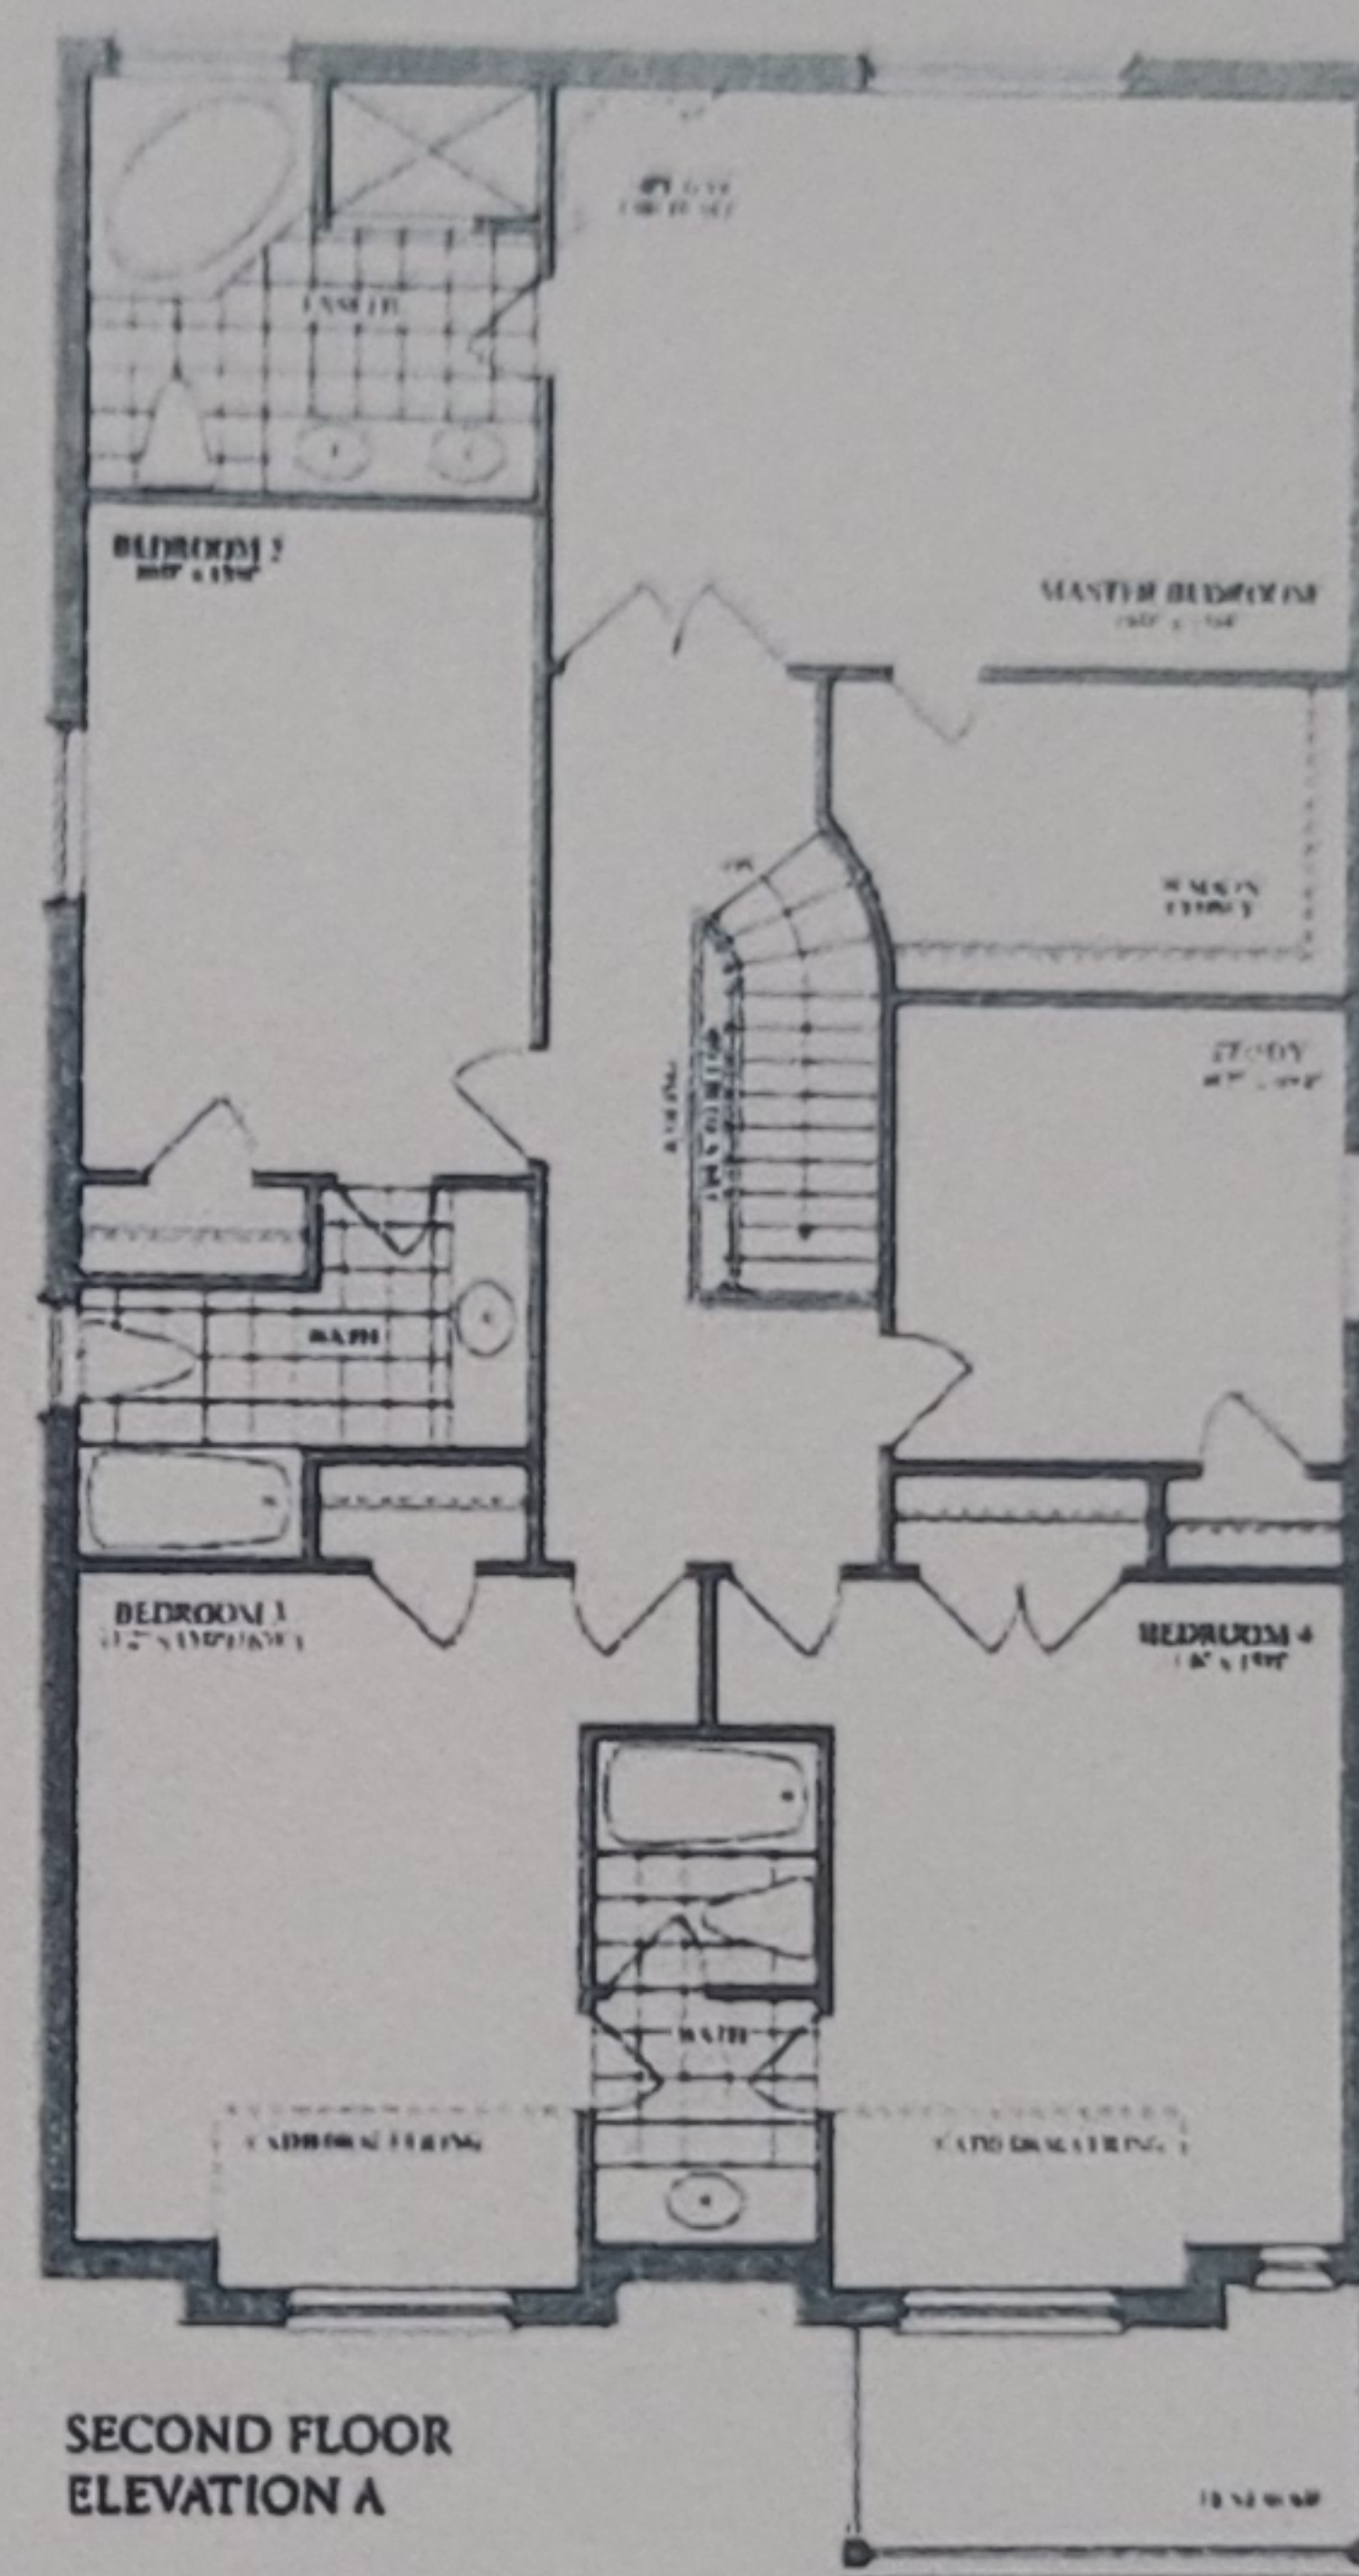


SECOND FLOOR
 ELEVATION A

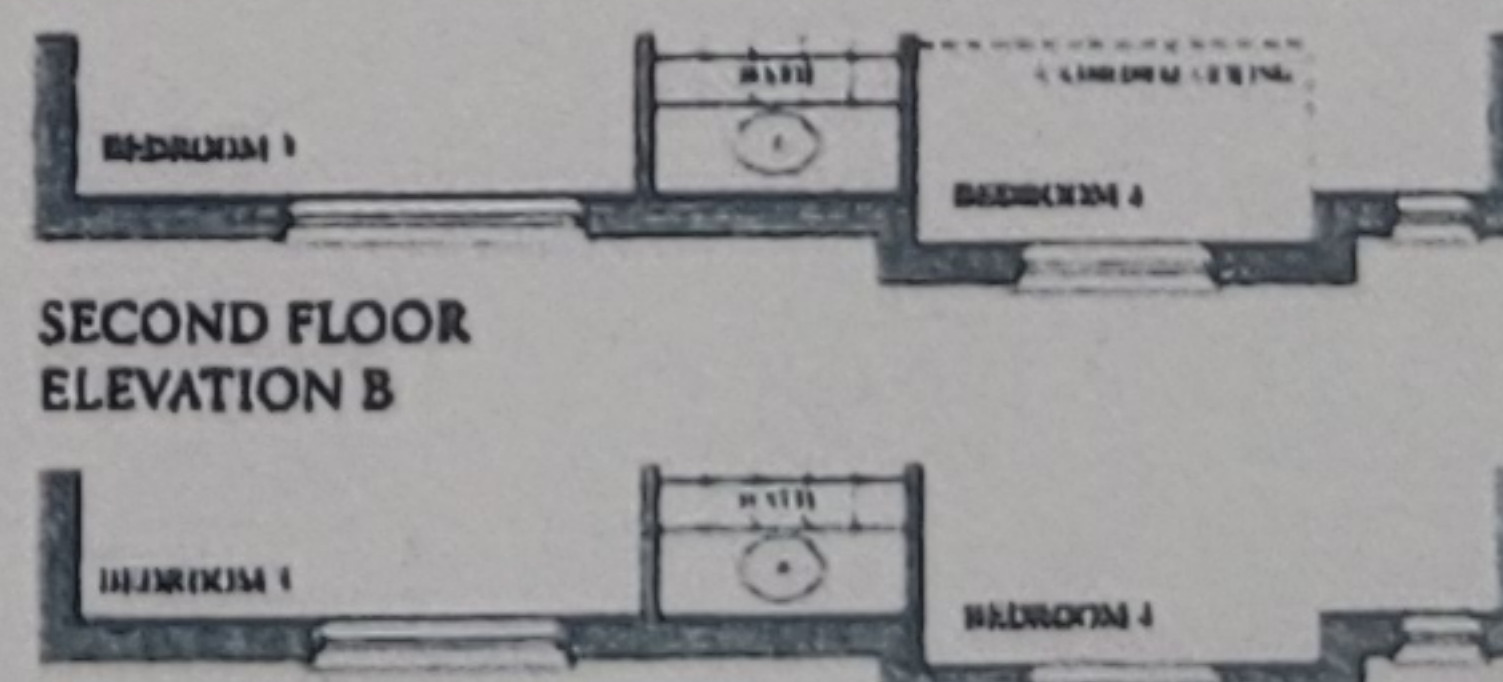

SECOND FLOOR
 ELEVATION B

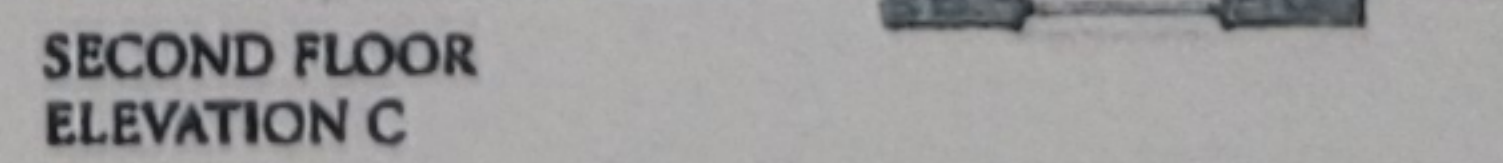

SECOND FLOOR
 ELEVATION C

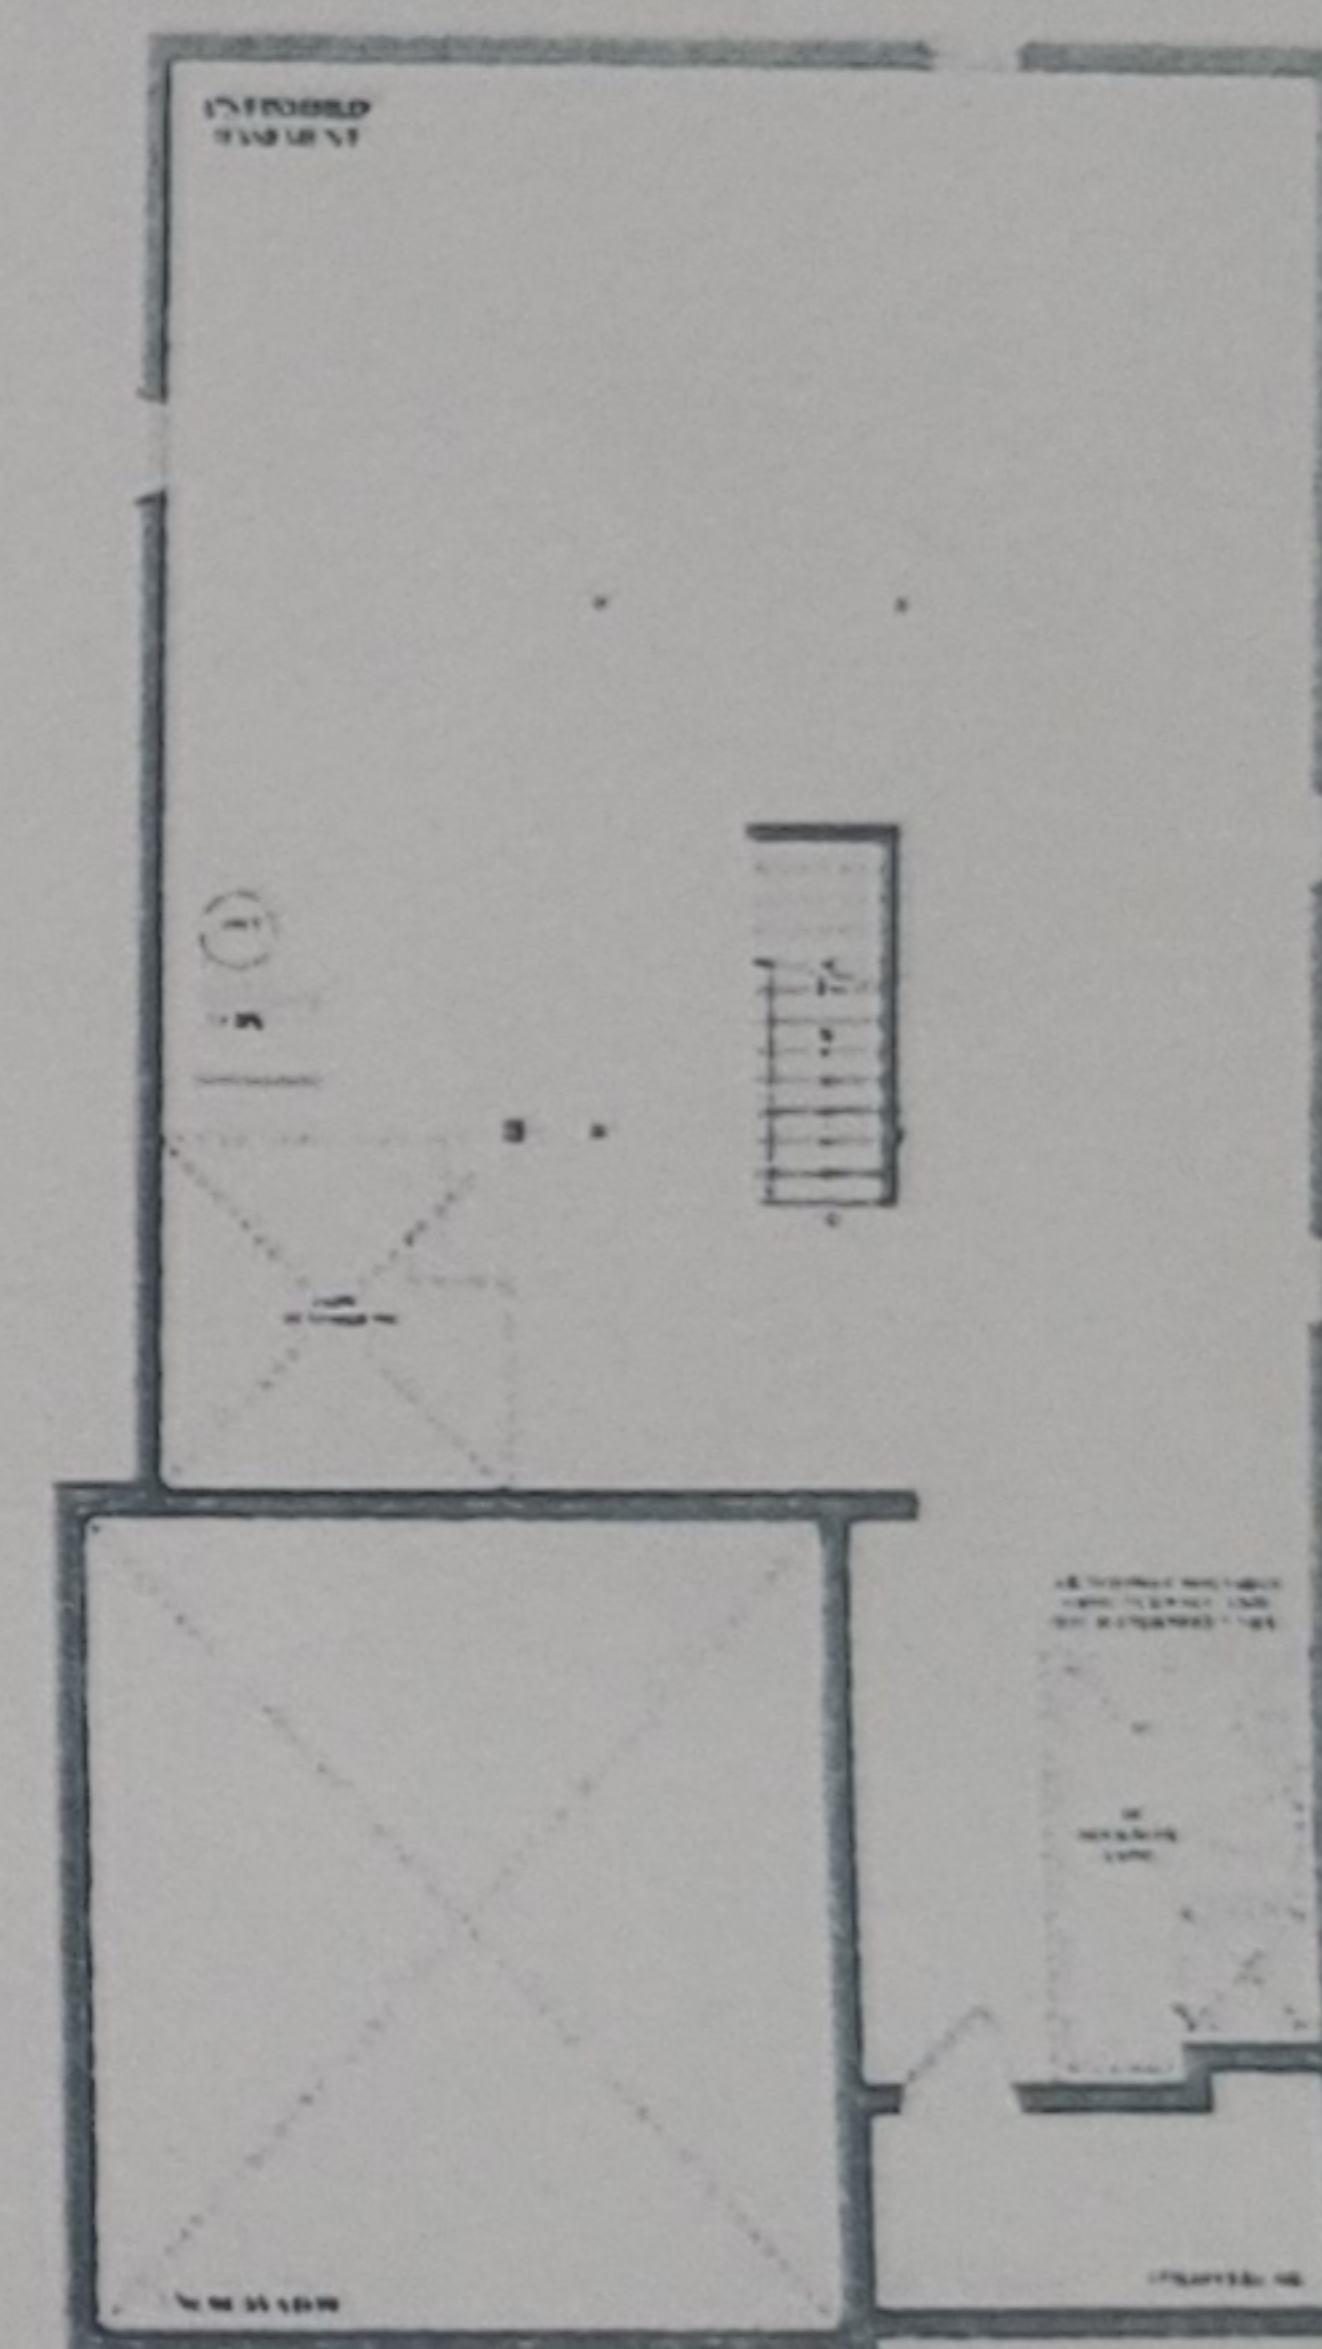

BASEMENT
 ELEVATION A, B, C

[Signature]
 15 JUNE 2021