


47'
DESIGNS



The Kahshe / Elev. A & B
3000 sq.ft.

Lot 1-180 PE #002

* WALK-UP
BASEMENT.

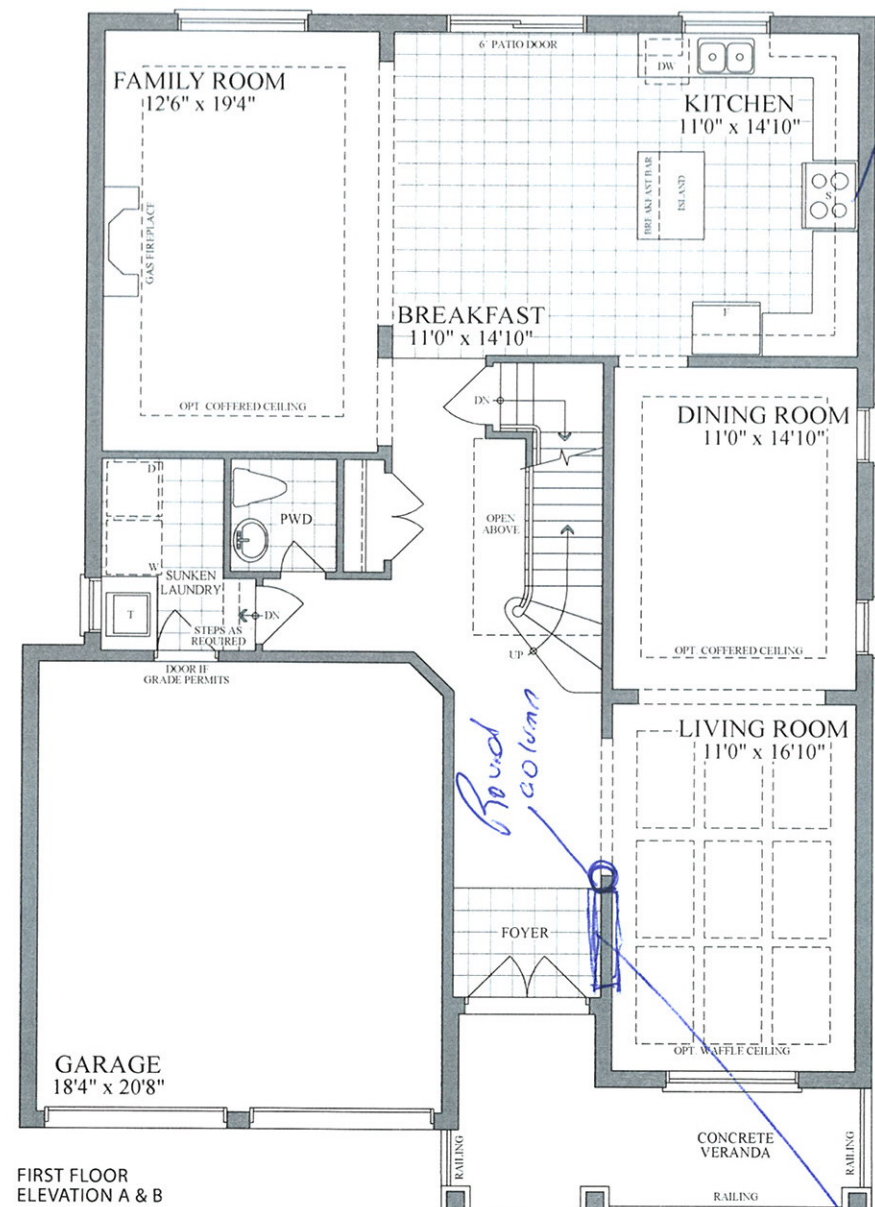

G.N

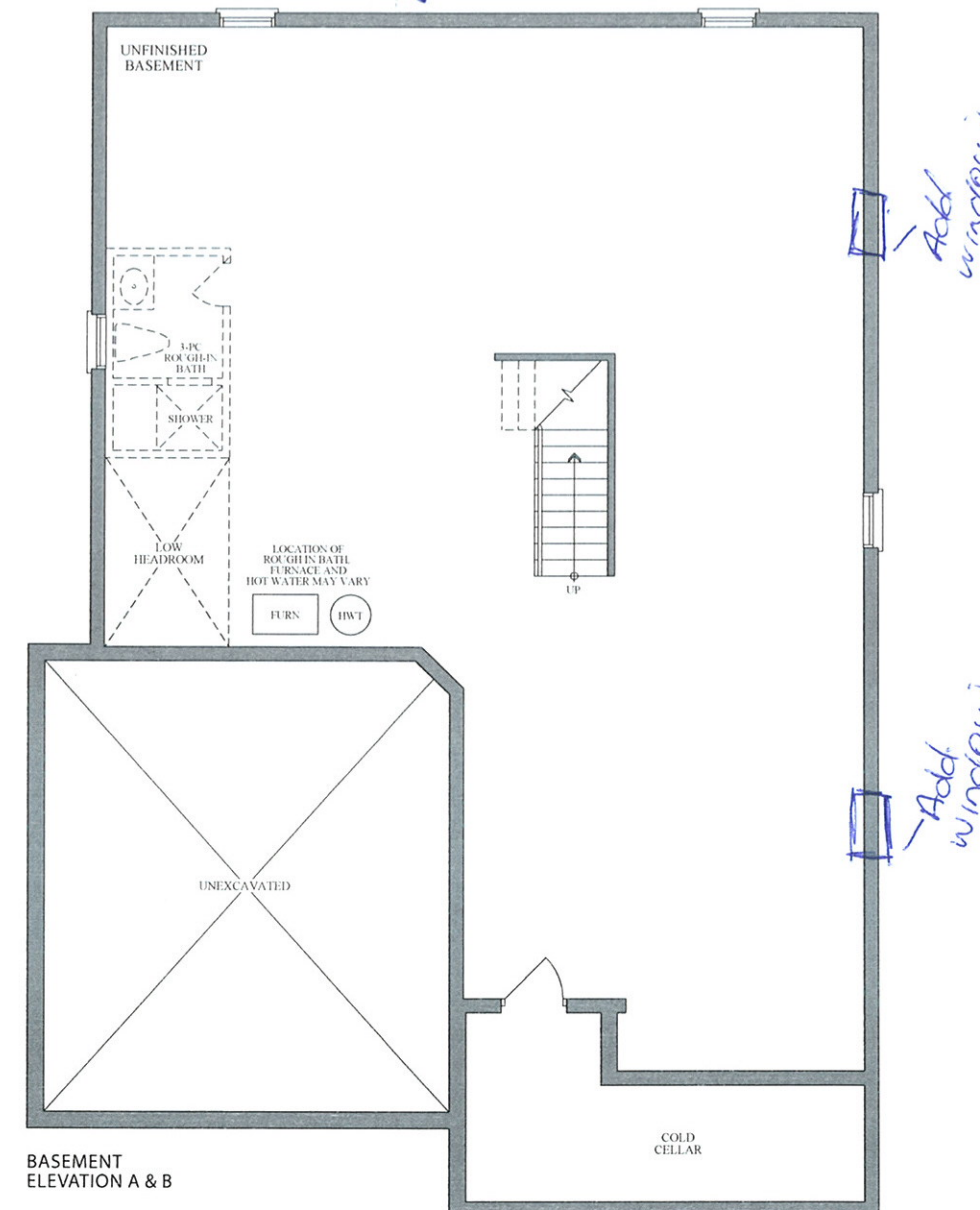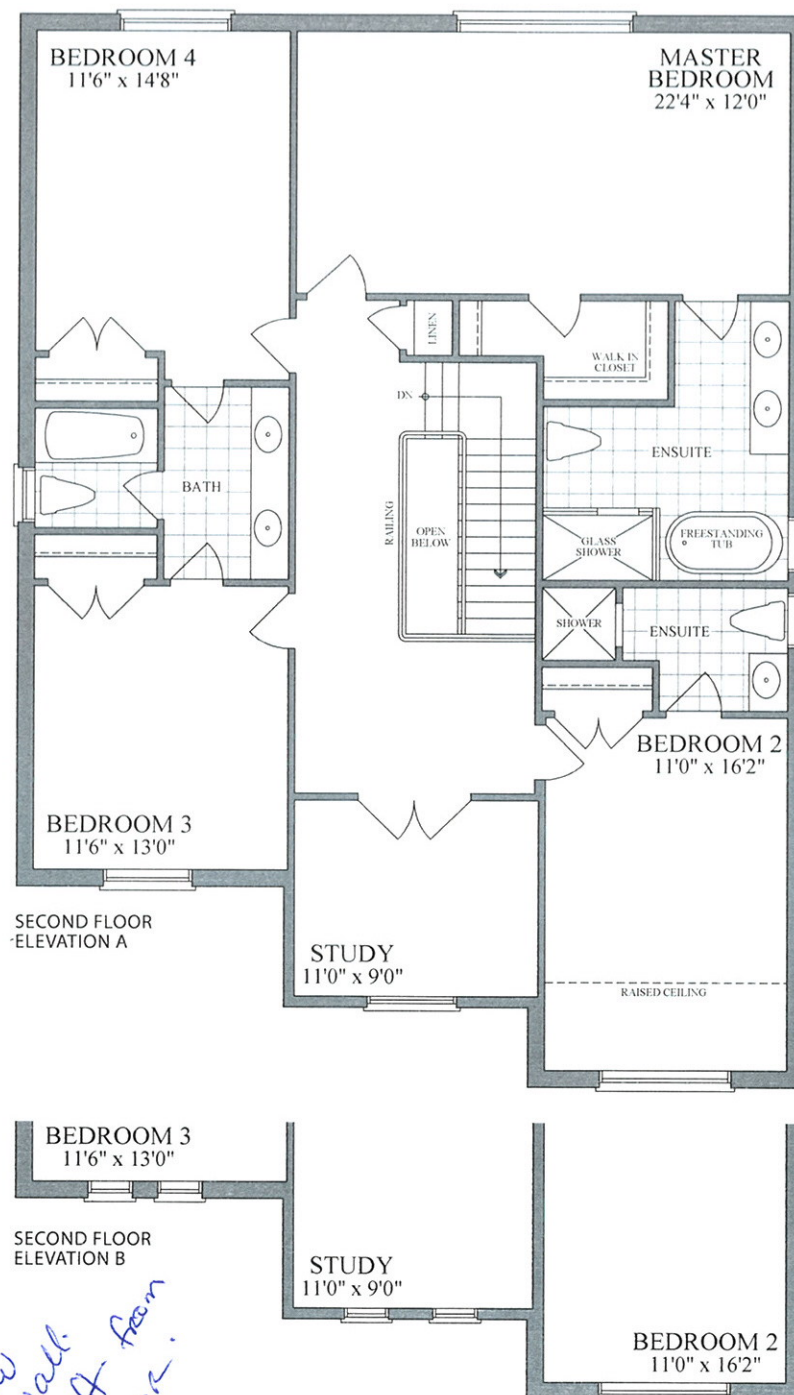

Plans and specifications are subject to change without notice. E. & O. E. Actual usable floor space may vary from the stated floor area. All renderings are artist's concept.

low wall
3ft. from
floor.

Add window

Add window