





The nipissing / Elev. A & B
3210 sq.ft.

C/E/S/
CONDUIT

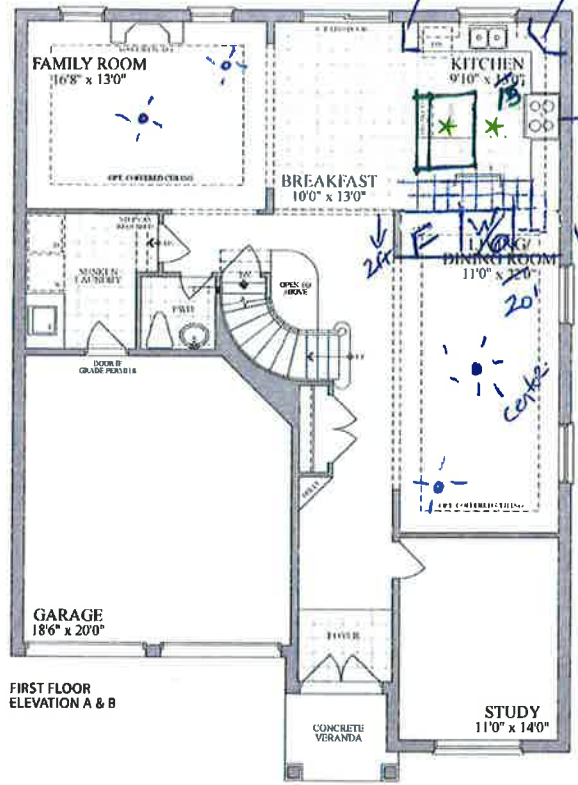


FIRST FLOOR
ELEVATION A & B

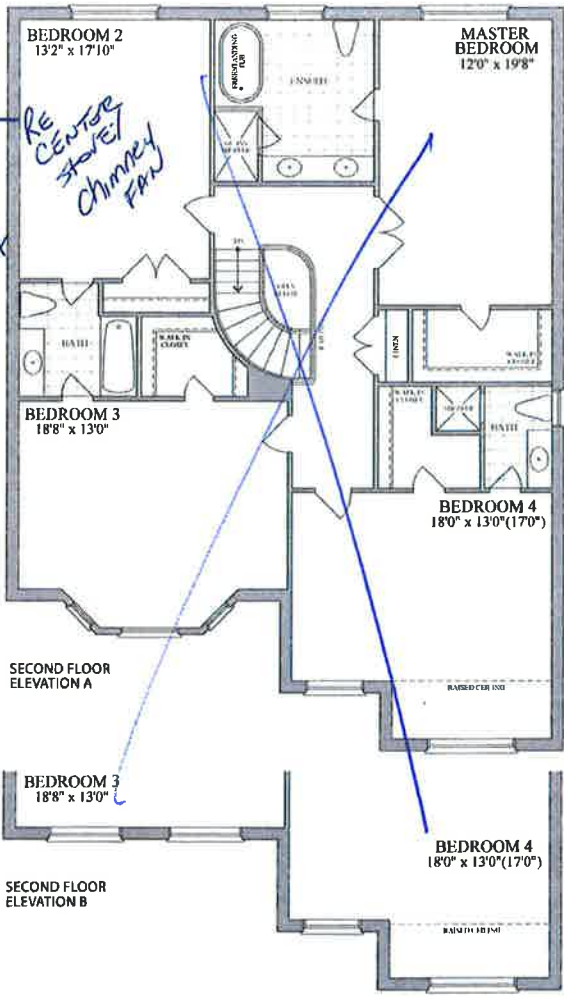


SECOND FLOOR
ELEVATION A

SECOND FLOOR
ELEVATION B

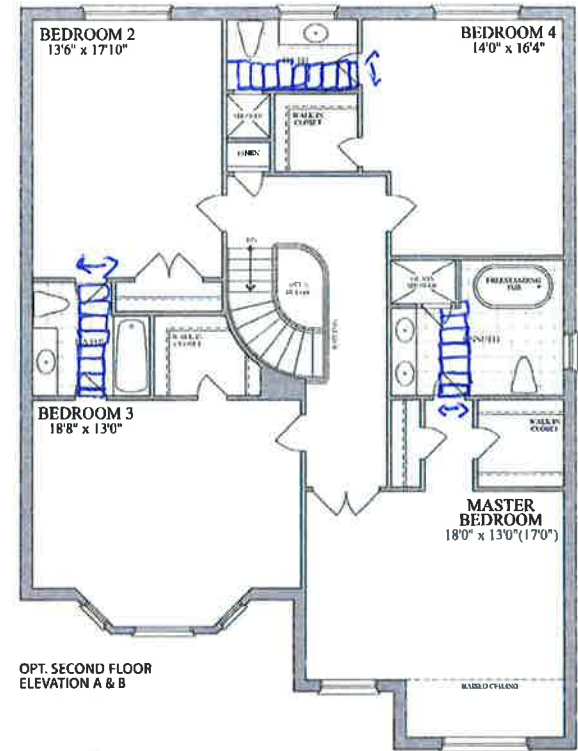

OPT. SECOND FLOOR
ELEVATION A & B

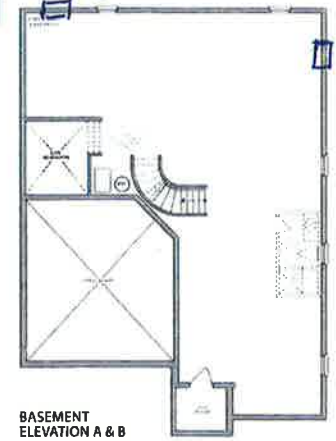

BASEMENT
ELEVATION A & B



PE002

Lot 2-24, Innisfil
PE-002



Purchaser's Initial H Patel
Hemantkumar Patel (Jul 15, 2021 19:38 EDT)

Plans and specifications are subject to change without notice. E & O C. Actual usable floor space may vary from the stated floor area. All renderings are artist's concept.