


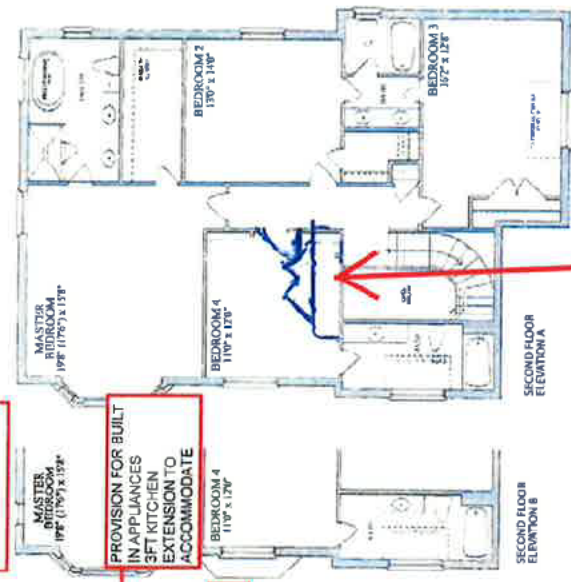

Bedroom - In lieu of two closets, relocate closet and provide 8ft closet

LOT 1-133, PH1, PE002- SKETCH

Zainab Dawari

PURCHASER: Zainab Dawari (Feb 13, 2022 12:50 GMT-11)

PURCHASER: _____

BUILT IN MICROWAVE IN ISLAND


8" VENT 36" COOKTOP ROUGH-IN POT FILLER GAS LINE FOR STOVE

PROVISION FOR BUILT IN APPLIANCES 3FT KITCHEN EXTENSION TO ACCOMMODATE

close opening between DR and KIT

8FT EXTERIOR FRENCH DOORS

PROVISION FOR WALL MOUNT TV, ELECTRICAL CONDUIT AND CAT6

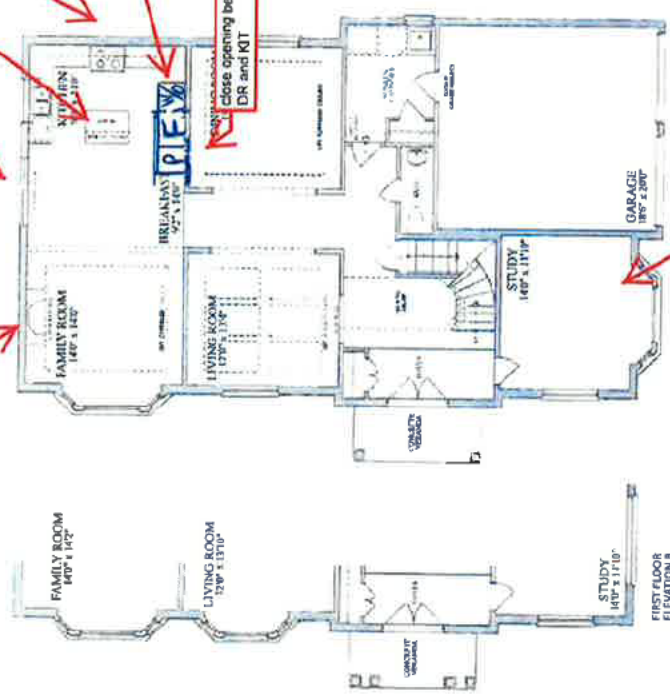

10 FT CEILINGS MAIN FLOOR

47'
DESIGNS

The Madawaska / Elev. A & B
3190 sq.ft.



Plans and specifications are subject to change without notice & A.S.E. is not responsible for errors or omissions.