

[illegible]

LE
AND
ST
F
C



1-134

CLOSET MADE 2' LARGER

CLOSET MADE 2' SMALLER
- REDUCED TO SINGLE
DOOR.


ED DESIGN SNOW LOADS SHALL
CONFORM TO CBC 9.4.2.2.
AND ROOF SPACES SHALL CONFORM
TO 9.4.2.4.

D OR SHEET STEEL WALL STUDS
IN THE MAIN BATHROOM IN A
W.C. UNIT, REINFORCEMENT SHALL BE
USED TO PERMIT THE FUTURE
INSTALLATION OF A GRAB BAR IN
CONFORMANCE WITH CBC 9.5.2.3.

OTHER THAN SAFETY GLASS SHALL
NOT BE USED FOR A SHOWER OR BATHTUB
ENCLOSURE. [CBC 9.6.1.4.]

MINIMUM WINDOW GLASS AREA FOR
BUILDINGS OF RESIDENTIAL
TYPE OR THAT ARE USED FOR
SLEEPING SHALL CONFORM TO TABLE B 9.7.2.3.

DOORS AND SKYLIGHTS SHALL
CONFORM TO CBC 9.8.7.

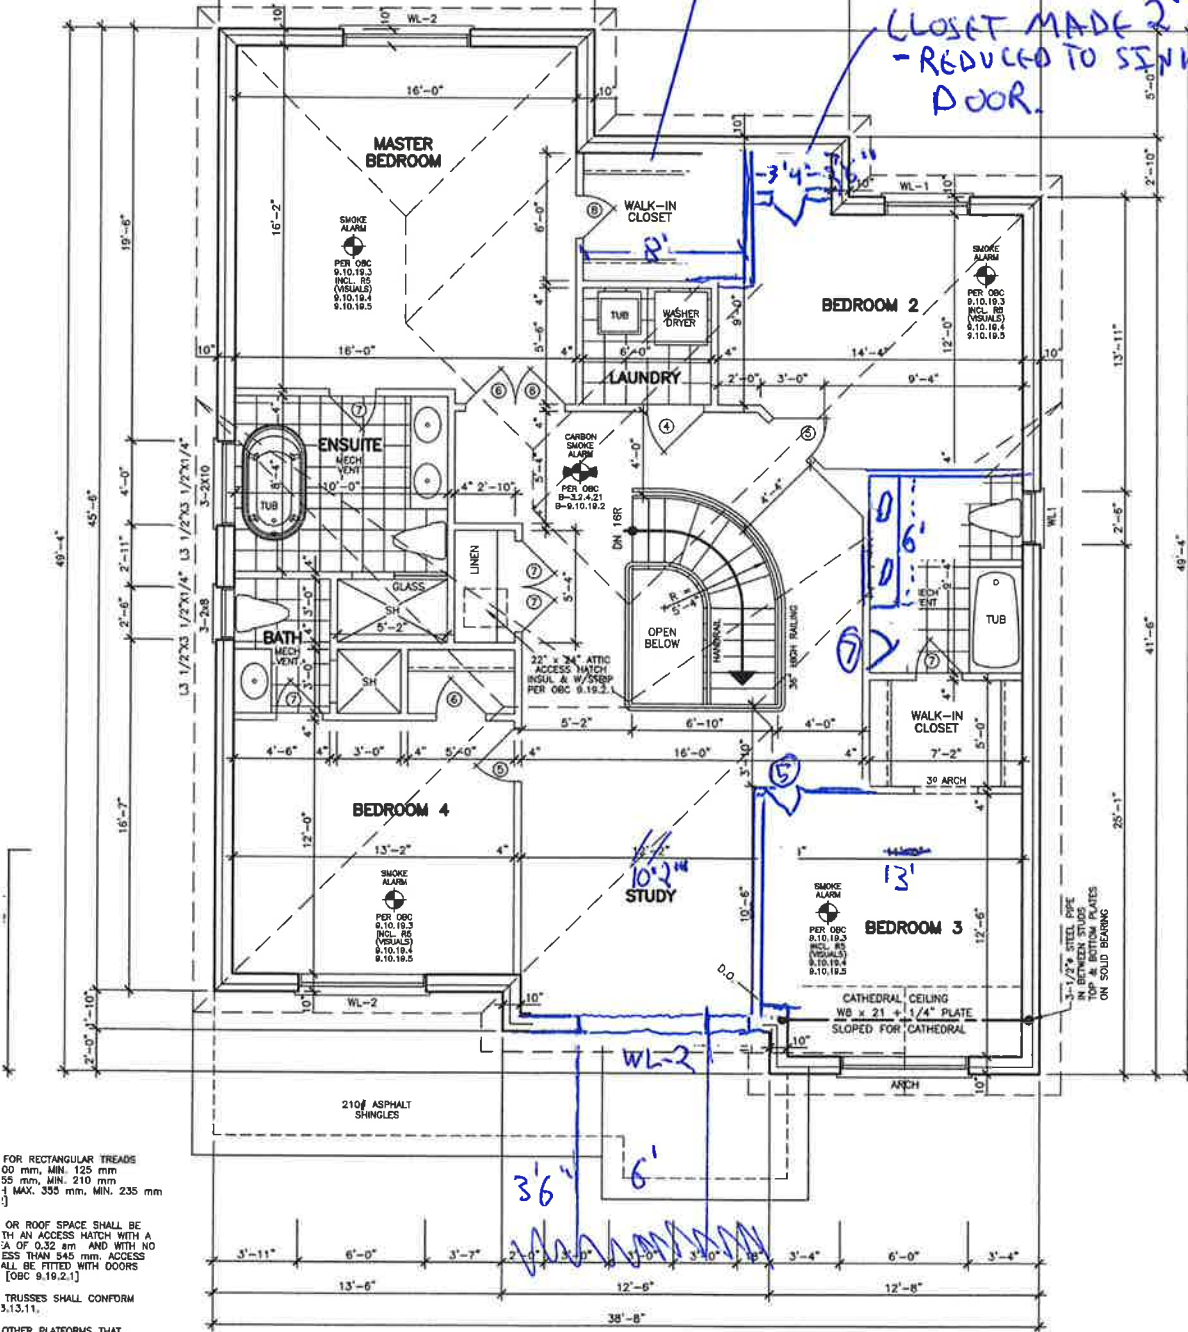

FOR RECTANGULAR TREADS
60 mm, MIN. 125 mm
55 mm, MIN. 210 mm
MAX. 355 mm, MIN. 235 mm

OR ROOF SPACE SHALL BE
WITH AN ACCESS HATCH WITH A
JACK OF 0.32 mm AND WITH NO
LESS THAN 245 mm ACCESS
ALL BE FITTED WITH DOORS
[CBC 9.10.2.1]

TRUSSES SHALL CONFORM
TO 9.13.11.

OTHER PLATFORMS THAT
SERVE AS ROOFS WITH RESPECT
TO THE PROTECTION OF THE
ROOF SHALL BE PROTECTED WITH
FLASHING, INSTALLED TO
EFFECTIVELY AND TO PREVENT
TO ICE DAMMING FROM
THE ROOF. [CBC 9.20.1.1]

SECOND FLOOR PLAN

ELC A

47' LOT

AR

The
as c
Guid
Date

ALL
OF
REF
THE
DM
DISP
DR

A

PRC
P
T
F

DRA
S
R
DATE
DRAW
CHECK
SEAL