
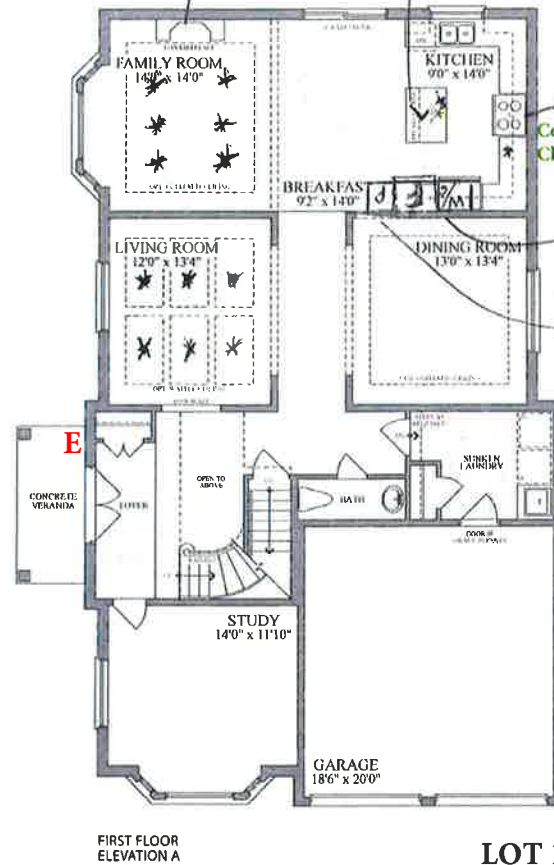


47'
DESIGNS

The madawaska / Elev. A & B
3190 sq.ft.

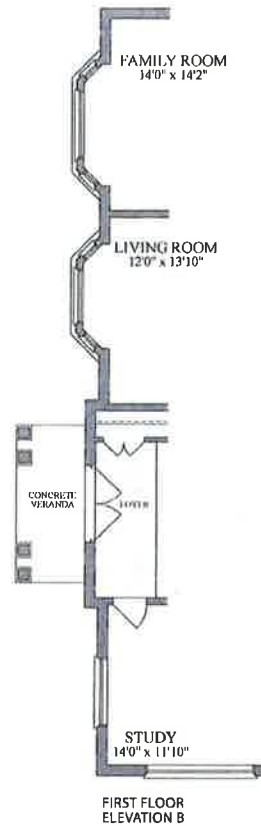

LOT 1-141, INNISFIL,
PE-002, SKETCH

Purchaser carmine marino
carmine marino (Jul 14, 2021 21:41 EDT)

Purchaser Johanne Marino
Johanne Marino (Jul 14, 2021 21:43 EDT)

Plans and specifications are subject to change without notice. E & O. Actual usable floor space may vary from the stated floor area. All renderings are artist's concept.

Built-in Micro in Island

SECOND FLOOR ELEVATION B

SECOND FLOOR ELEVATION A

