



forming part of the Agreement of Purchase and Sale

BELLAI RE PROPERTIES INC.

P.E.#: 002

[illegible]

- The Vendor will undertake to install the above extras but will not be liable to the purchaser if for any reason the work covered by the extra is not carried out. In that event, the price of the extra shall be refunded to the purchaser without any interest.
- It is understood and agreed that if the transaction of Purchase and Sale is not completed for any reason whatsoever, the total cost of this extra is not refundable.

PURCHASER


Per: _____
VENDOR

Handwritten signature

One (1) Additional
Basement
Window
Lowell

shower seat to be next to tub

BSMT. window to be
approx 5' front he corner

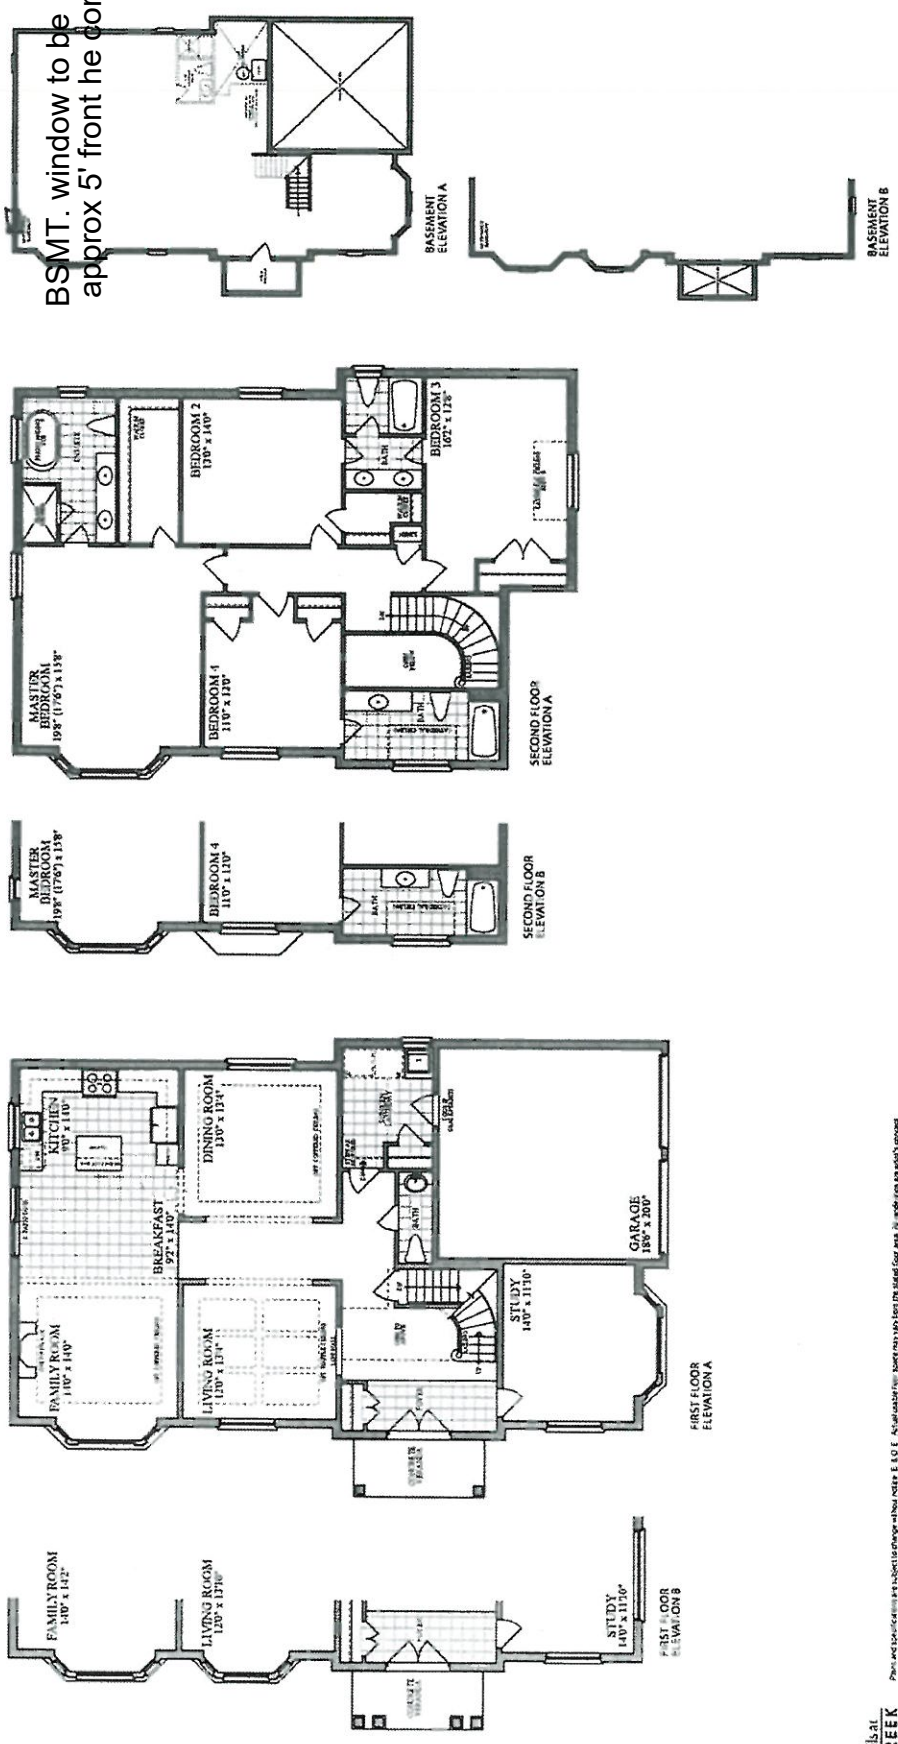

The Madawaska / Elev. A & B
3190 sq.ft.



Plans and specifications are subject to change without notice. E. & O. E. Actual results may vary from the stated floor area. All measurements are subject to survey.