


*Handwritten signature*

One (1) Additional Basement Window

shower seat to be next to tub

BSMT. window to be approx 5' front he corner

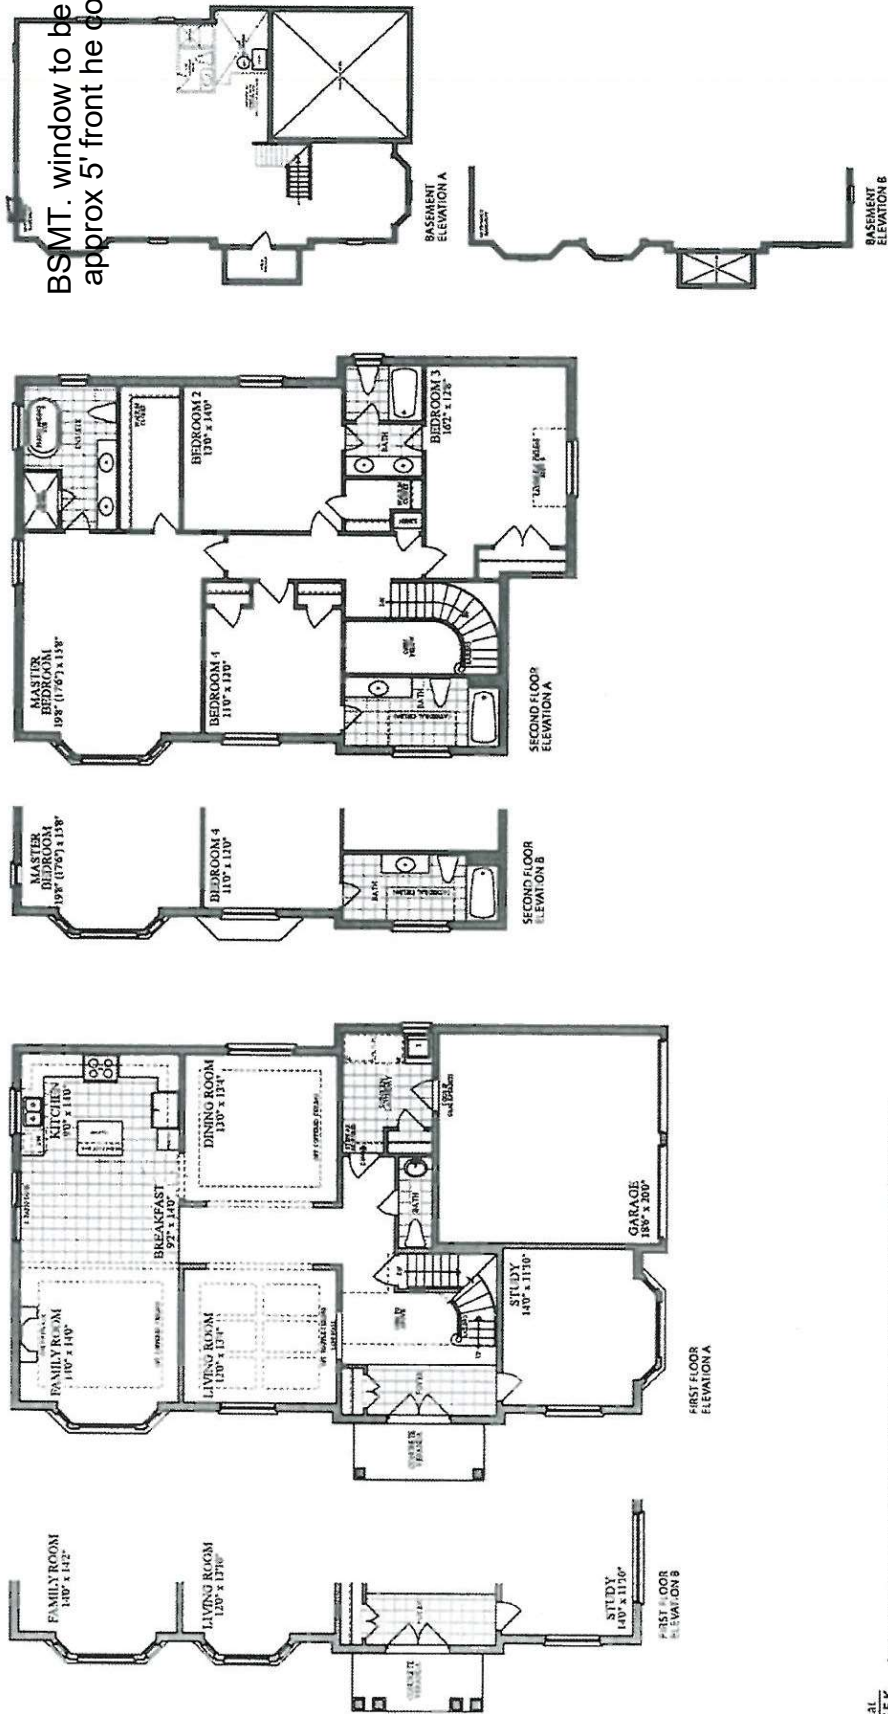

Plans and specifications are subject to change without notice. © 2011 E. All rights reserved. Plans may vary from the stated floor area. All measurements are subject to change.