





Detached - Additional PE Form - 04/30/15

The Nipissing / Elev. A & B
3210 sq.ft.



Plans and specifications are subject to change without notice. E. & O. E. Actual usable floor space may vary from the stated floor area. All renderings are artist's concept.

① Built in Appliances
② 10ft ceilings on main
③ 9ft ceiling on 2nd floor
8ft door

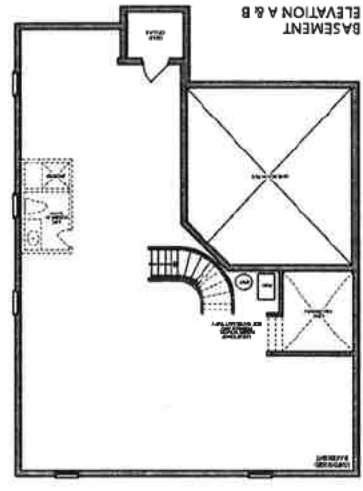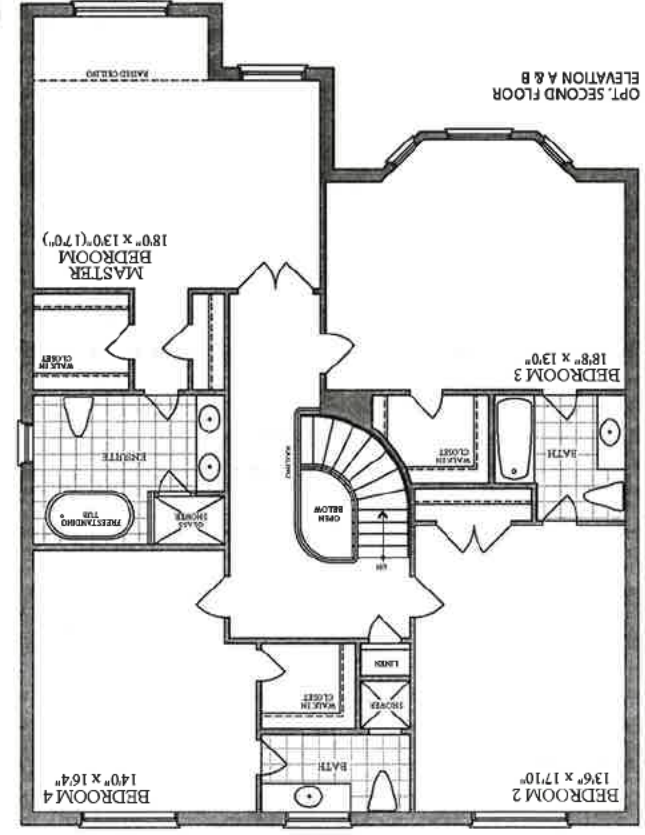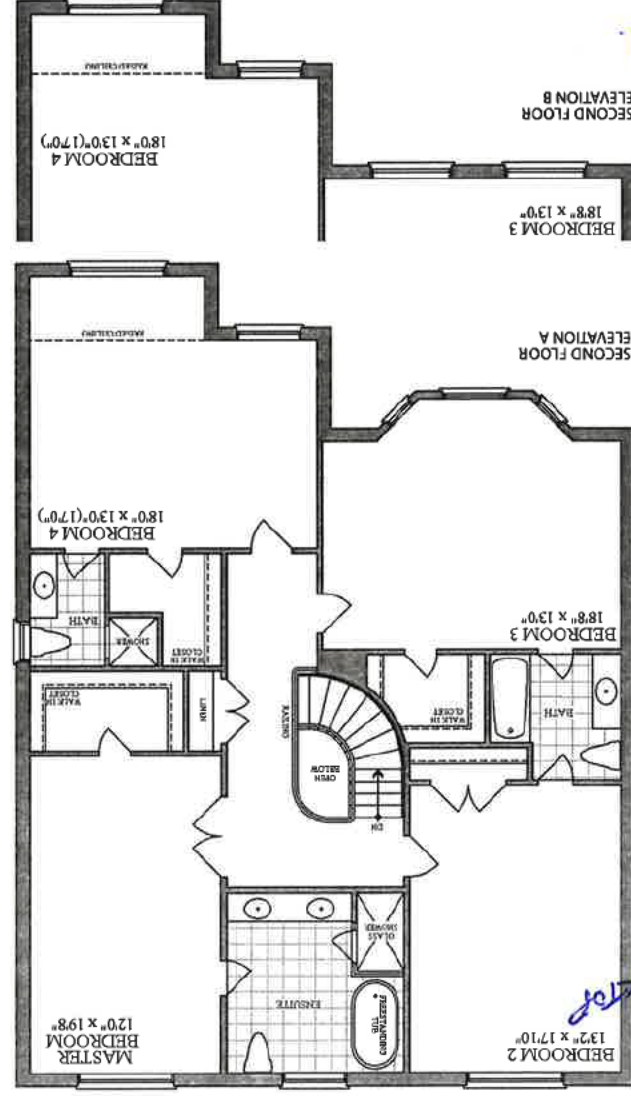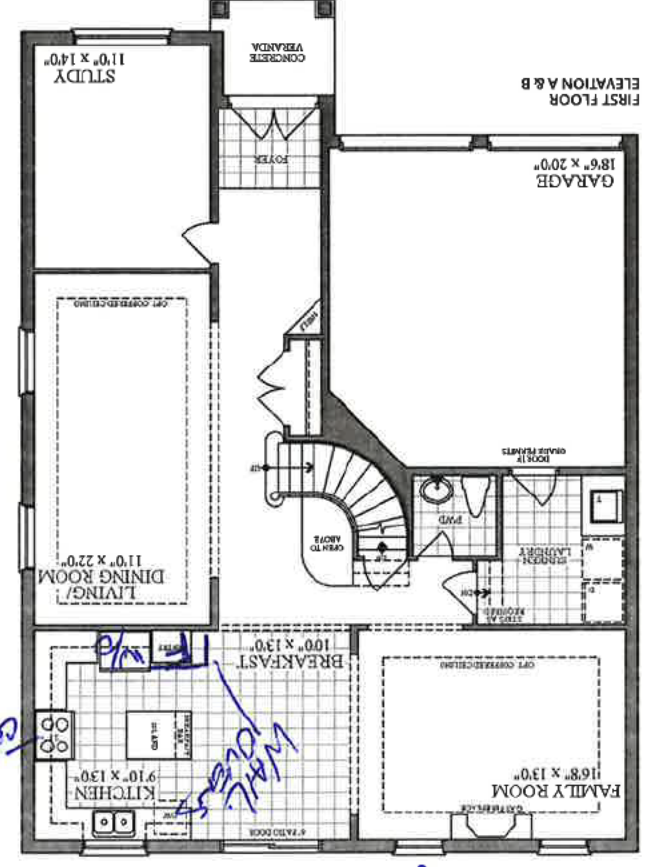

Lot 2-66

UX