

LOT 2-22, PE002, SKETCH

split 10' x 8' kitchen
location
main living area
split 10' x 8' kitchen

8ft clear

Shift
Fireplace

Light
above
cage


upper
angled
cabinet

CAGE


Journal

→ Add window
5ft from
corner.

5ft x 11ft window

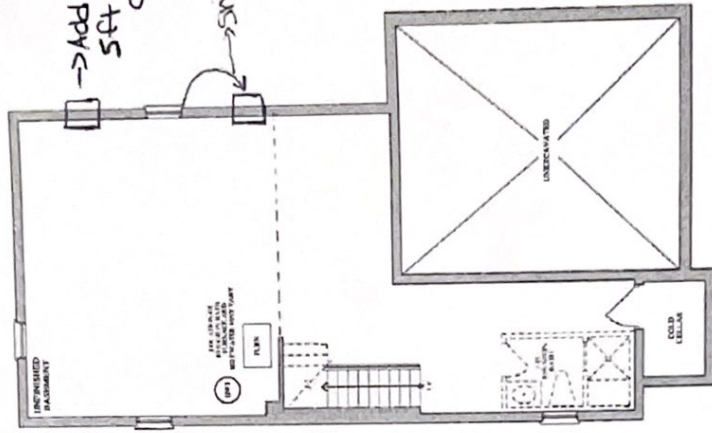


BASEMENT
ELEVATION A & B

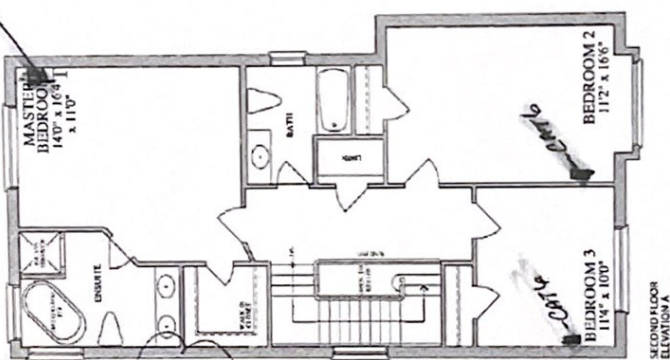

SECOND FLOOR
ELEVATION A



SECOND FLOOR
ELEVATION B

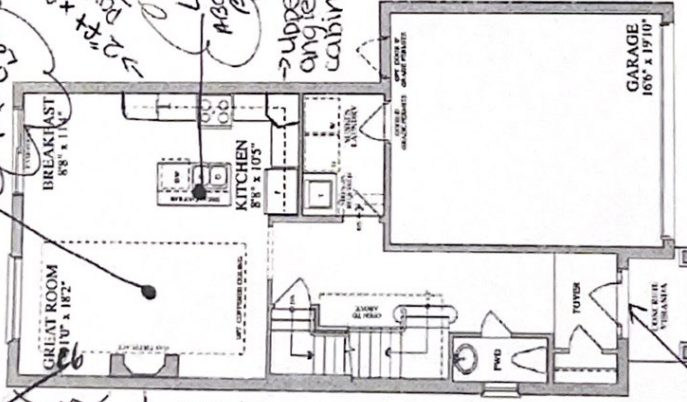

FIRST FLOOR
ELEVATION A & B

Front door
42" width
sidelight

Lot 2-22, PE003
Revisions to Light +
Cable R/I's

V. Volodin V.V.
N. Volodina N.V.