
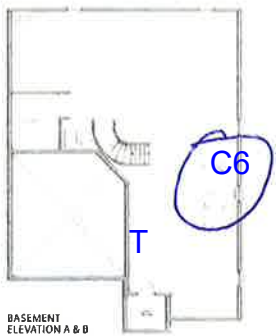


**47'**  
DESIGNS

The Nipissing / Elev. A & B  
**3210** sq.ft.

 **the creek at**  
**CARSON'S CREEK**

PLAN AND ELEVATIONS ARE SUBJECT TO CHANGE AND NOT TO SCALE. E & O E. © 2014 47' DESIGNS. ALL RIGHTS RESERVED. THIS PLAN IS THE PROPERTY OF 47' DESIGNS. ANY REPRODUCTION OR DISTRIBUTION OF THIS PLAN IS STRICTLY PROHIBITED.

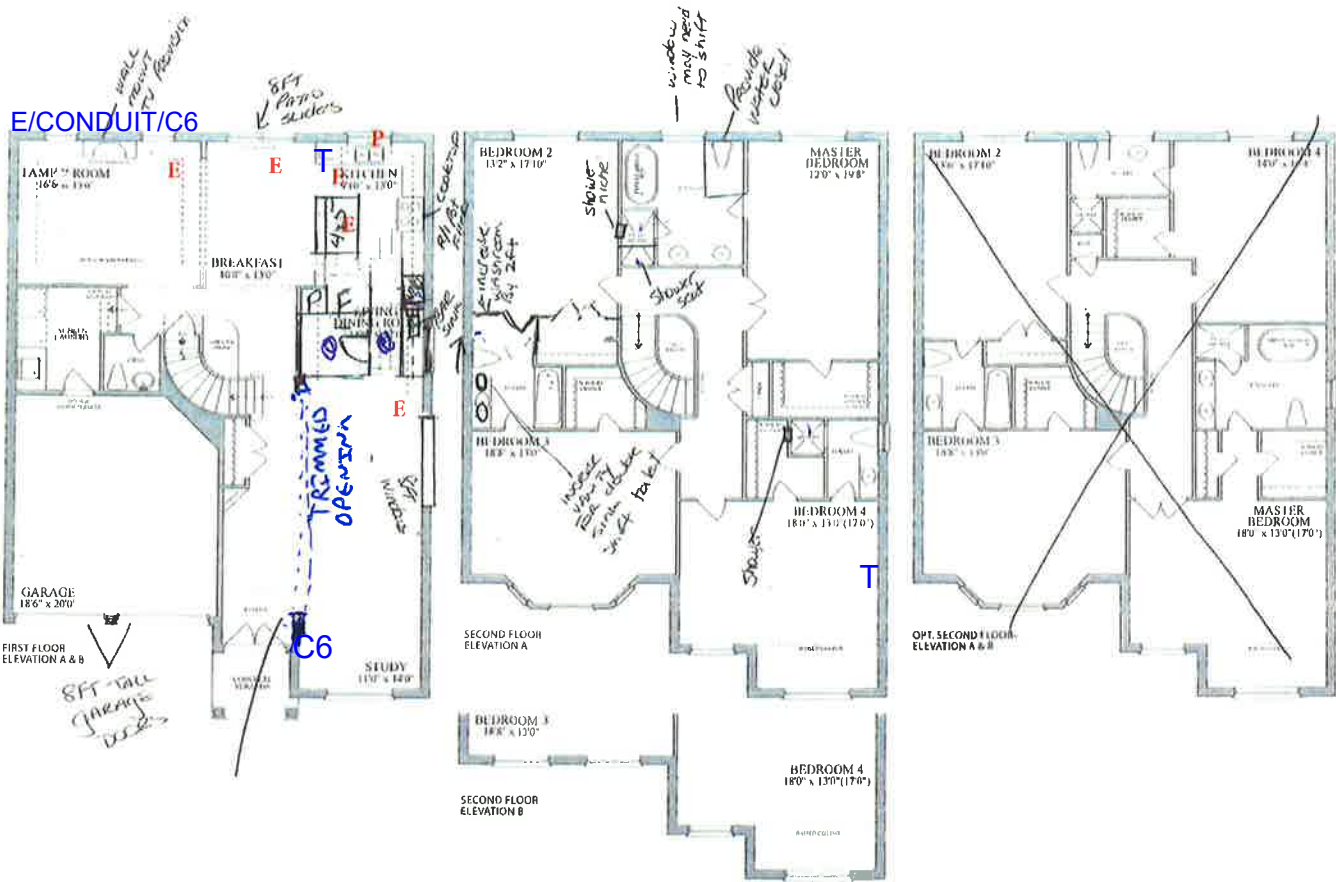

LOT 2-63, PH2, INNISFIL, PE002  
PURCHASER: \_\_\_\_\_  
PURCHASER: \_\_\_\_\_