



BELLAIRE PROPERTIES INC. (CARSON’S CREEK)
PURCHASER EXTRAS

LOT 034 P.E #003 – Model - MANITOU - 2480 - PHASE 5

Attention Trades...

The following items below are Purchaser Extras, please make sure that they are done on time and properly complete. Any outstanding items will be Back Charged. If you have any questions please call Roberto Ruiz. Make sure that you review ALL of the items on the Purchaser Extras.

Please be advised that Purchase Orders will come at a later date.

***Also, it is very important to speak to Roberto Ruiz before starting on site **

TRADE: ITEMS TO BE COMPLETED

Allstar Carpentry	#1
Barrie Trim	#1

Date: Mar 11, 2022
From: Lormel Homes
Site Clerk: Jai Fitzgerald
Site Tel: 905-775-3633
Site Fax: 905-775-9083

NOTE: If more information is needed please call Roberto Ruiz cell-416-688-9324
If more information needed on quotes or changes, please call Zachary 905-832-2023 ext. 224



forming part of the Agreement of Purchase and Sale

BELLAIRE PROPERTIES INC.

P.E.#: 003

[illegible]

It is understood and agreed that if the transaction of Purchase and Sales is not completed for any reason whatsoever, the total cost of the extra is not refundable.

PAID:

PURCHASER

PURCHASER

BELLARE PROPERTIES INC

Per:

VENDOR

and if it is not completed for any reason whatsoever, the total cost of this extra is not

File Copy for

TERMS: CALL FOR SPECIFICATIONS AND ADVANCE

Construction


BELLARE PROPERTIES INC

Per: 

VENDOR

Office

(Original verified at Head Office)

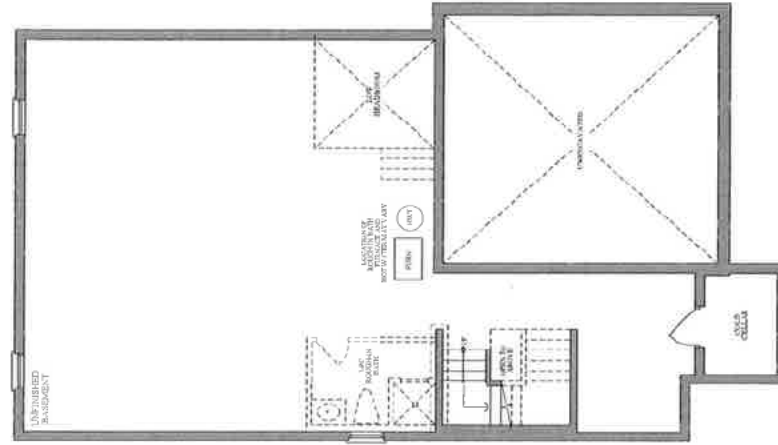


BASEMENT
ELEVATION A & B

LOT 5-34, PH5, PE003

PURCHASER: WILLIAM & JILL


PURCHASER: WILLIAM & JILL

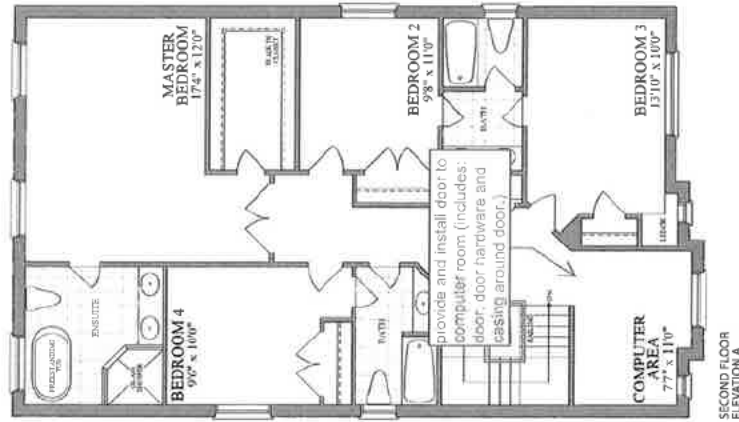

SECOND FLOOR
ELEVATION A



SECOND FLOOR
ELEVATION B

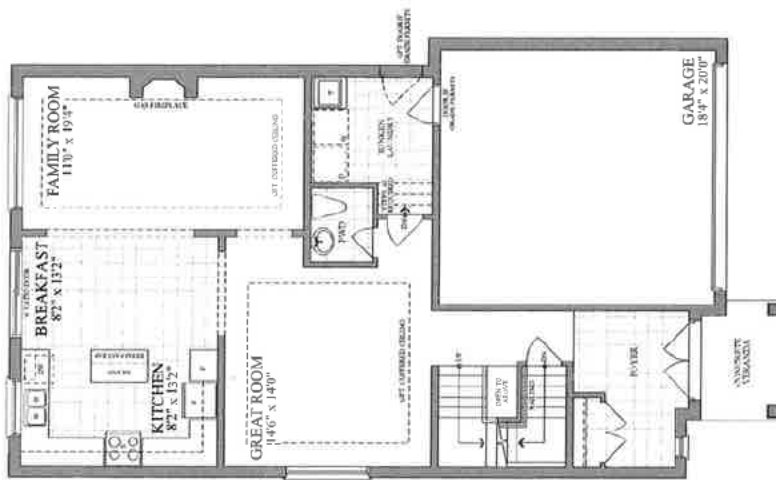

FIRST FLOOR
ELEVATION A & B

Plans and specifications are subject to change without notice. A.D.E. Actual results may vary from the stated floor area. All measurements are within 1/8 inch.

38'
DESIGNS

The **Manitou** / Elev. A & B
2480 sq.ft.



The manitou / Elev. A & B
2480 sq.ft.



LOT 5-34, PH5, PE003

PURCHASER: HUGO BOSS LTD 037, 2022 10/04/25/21PURCHASER Bill JEFFREY SACHS, LLC 06/16/2022 11:48 EST