



BELLAIRE PROPERTIES INC. (CARSON’S CREEK)
PURCHASER EXTRAS

LOT 088 P.E #003 – Model - MANITOU - 2480 - PHASE 5

Attention Trades...

The following items below are Purchaser Extras, please make sure that they are done on time and properly complete. Any outstanding items will be Back Charged. If you have any questions please call Roberto Ruiz. Make sure that you review ALL of the items on the Purchaser Extras.

Please be advised that Purchase Orders will come at a later date.

*****Also, it is very important to speak to Roberto Ruiz before starting on site ****

TRADE: ITEMS TO BE COMPLETED

Allstar Carpentry	#1
Brown Window	#1

Date: Mar 14, 2022
From: Lormel Homes
Site Clerk: Jai Fitzgerald
Site Tel: 905-775-3633
Site Fax: 905-775-9083

NOTE: If more information is needed please call Roberto Ruiz cell-416-688-9324
If more information needed on quotes or changes, please call Zachary 905-832-2023 ext. 224



forming part of the Agreement of Purchase and Sale

BELLAIRE PROPERTIES INC.

P.E.#: 003

[illegible]


- The Vendor will undertake to install the above extras but will not be liable to the purchaser if for any reason the work covered by the extra is not carried out. In that event, the price of the extra shall be refunded to the purchaser without any interest.
- It is understood and agreed that if the transaction of Purchase and Sale is not completed for any reason whatsoever, the total cost of this extra is not refundable.

PURCHASER

(Original verified at Head Office)

38'
DESIGNS

The Manitou / Elev. A & B
2480 sq.ft.

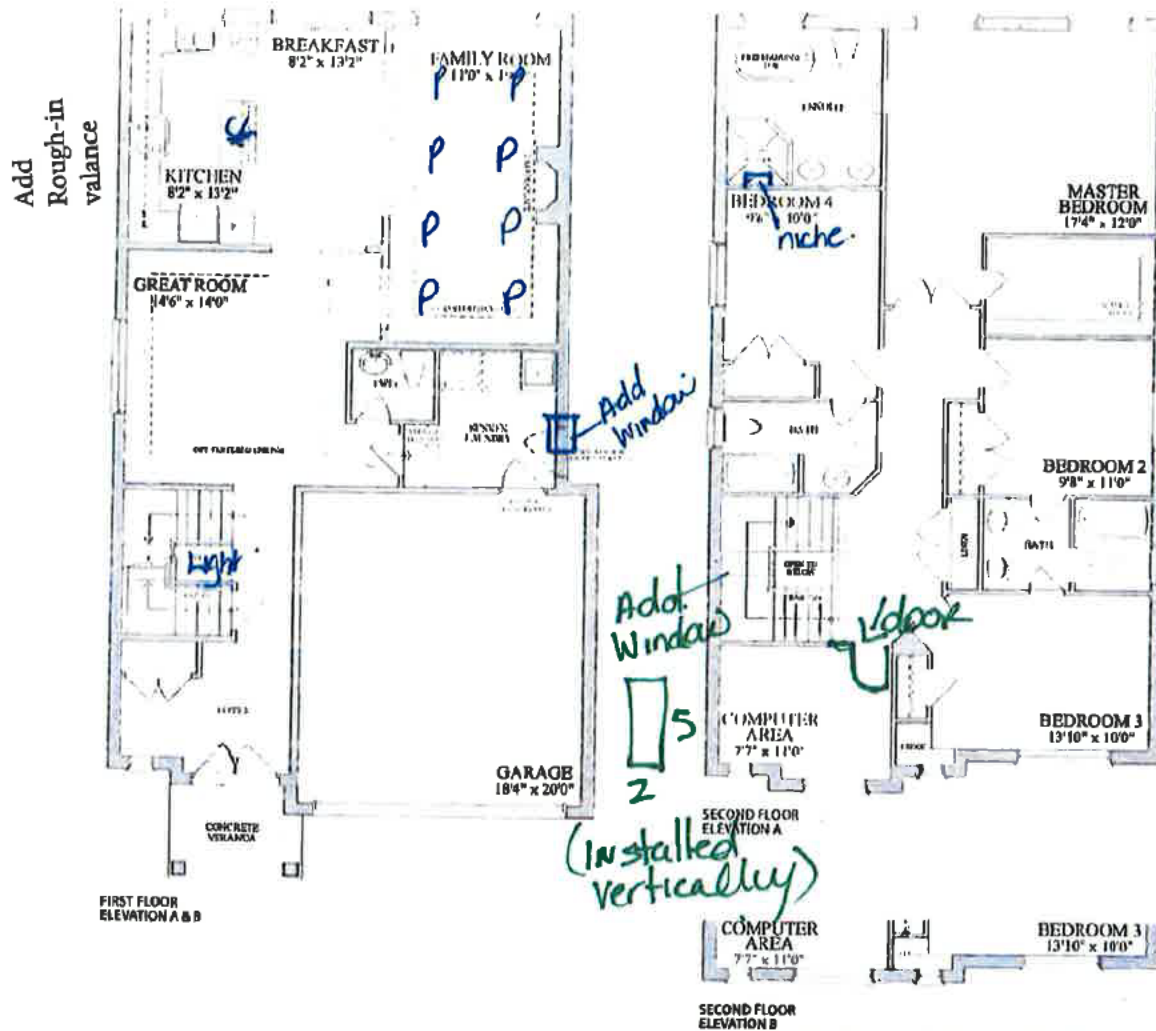


LOT 5-88, PE003, SKETCH

kenneth egede

Purchaser: kenneth egede (Nov 24, 2021 12:04 EST)

Purchaser: _____

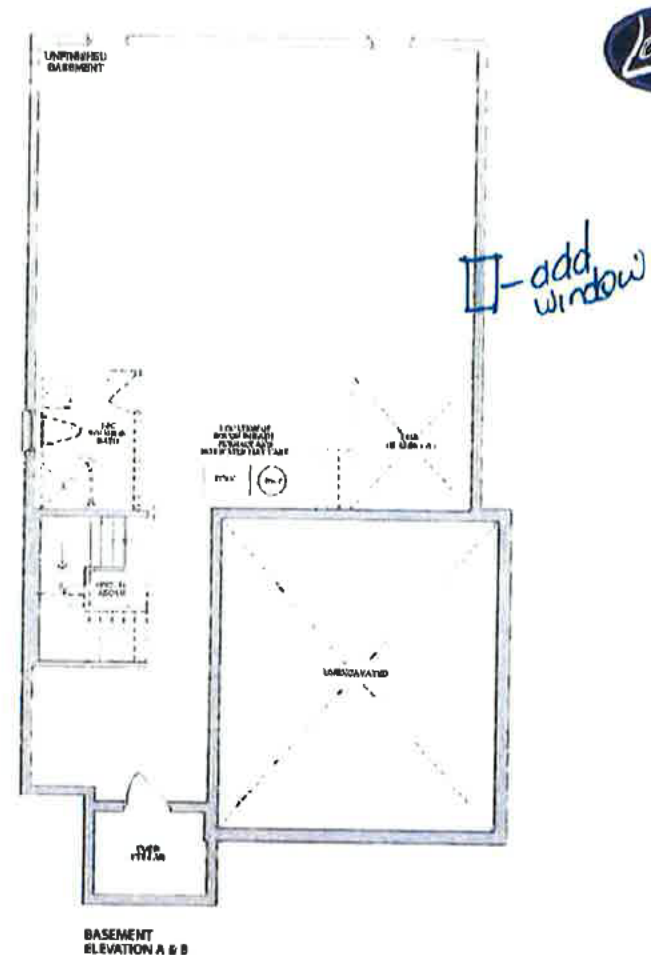

LOT 5-88, PE003, SKETCH

kenneth egede

PURCHASER: kenneth egede (Nov 2, 2021 12:13 EDT)

PURCHASER: _____



The manitou / Elev. A & B
2480 sq.ft.



kenneth egede

Purchaser: _____



PURCHASER _____