


47'
DESIGNS

The **nipissing** / Elev. A & B
3210 sq.ft.

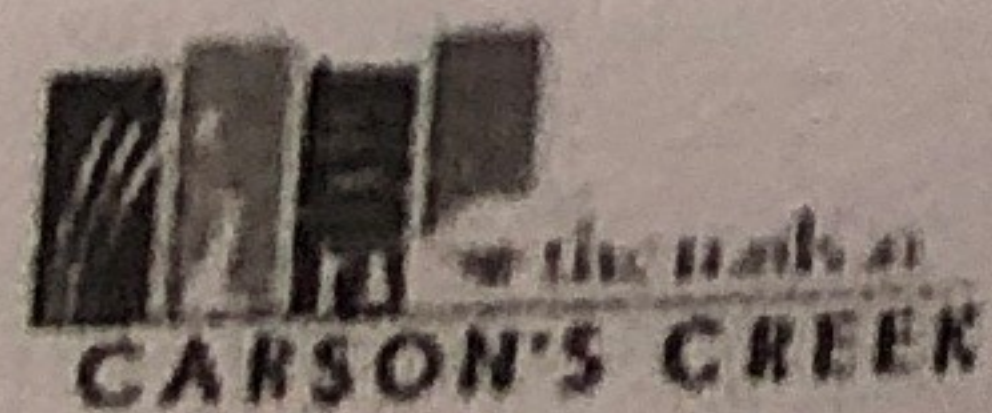

E/CONDUIT/C6

8 ft
1 Pat 0

E/CONDUIT/C6

LAMP ROOM

BREAKFAST

GARAGE
18'6" x 20'0"

FIRST FLOOR
ELEVATION A & B

8FT TALL
GARAGE

C6

SECOND FLOOR
ELEVATION A

SECOND FLOOR
ELEVATION B

BEDROOM 2
11'3" x 12'10"

MASTER
BEDROOM
12'0" x 14'0"

HYDROM 4
180' x 130' (170')

BEDROOM 4
12'0" x 11'0" (11'0" x 12'0")

OPT, SECOND FLOOR
ELEVATION A & B

MASTER
BEDROOM

BASEMENT
ELEVATION A & B

LOT 2-63, PH2, INNISFIL, PE002

PURCHASER: _____

PURCHASER: _____

PLEASE PRINT SPECIALLY FOR THE CHIEF OF POLICE. DO NOT WRITE IN THESE SPACES. IF YOU HAVE ANY COMMENTS, PLEASE WRITE THEM IN THE SPACE PROVIDED. IF YOU HAVE ANY COMMENTS, PLEASE WRITE THEM IN THE SPACE PROVIDED.