

FIRST FLOOR ELEVATION A & B


Please indicate the location of the rough-ins on your plan

Description	Symbol/Sketch	Standard Locations
Cable (Rough-in)	C	Family room Or Great Room, all bedrooms, Study/Den/Computer, (as per model)
Cat5	CS	A Cat5 wire can replace the rough-in cable at no additional cost.
Cat6	CG	Upgrade - \$50 per location
Telephone (Rough-in)	T	Kitchen and Primary Ensuite
Smart-Wire (Cat5)	S	Can be Installed a Purchaser's desired location




OPT. FIRST FLOOR


LOT #: 1-176  
PURCHASER: [Signature]  
PURCHASER: [Signature]

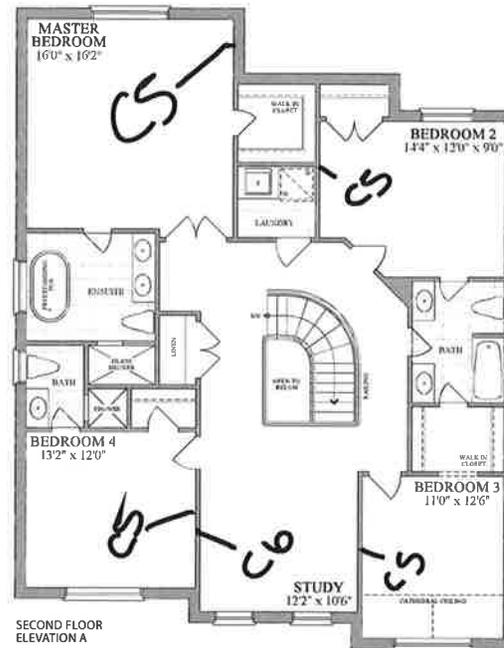

SECOND FLOOR ELEVATION A

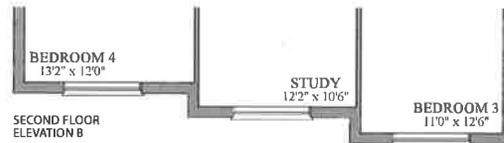

SECOND FLOOR ELEVATION B

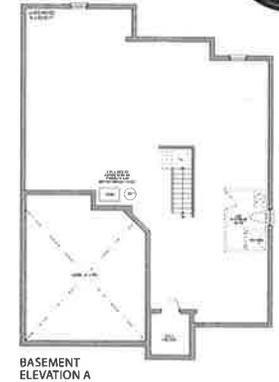

BASEMENT ELEVATION A



BASEMENT ELEVATION B



BASEMENT ELEVATION C

