


47' designs

The madawaska / Elev. A & B
3190 sq.ft.



Plans and specifications are subject to change without notice. © B.D.C. Actual sample floor space may vary from the stated floor area. All renderings are artist's concept.

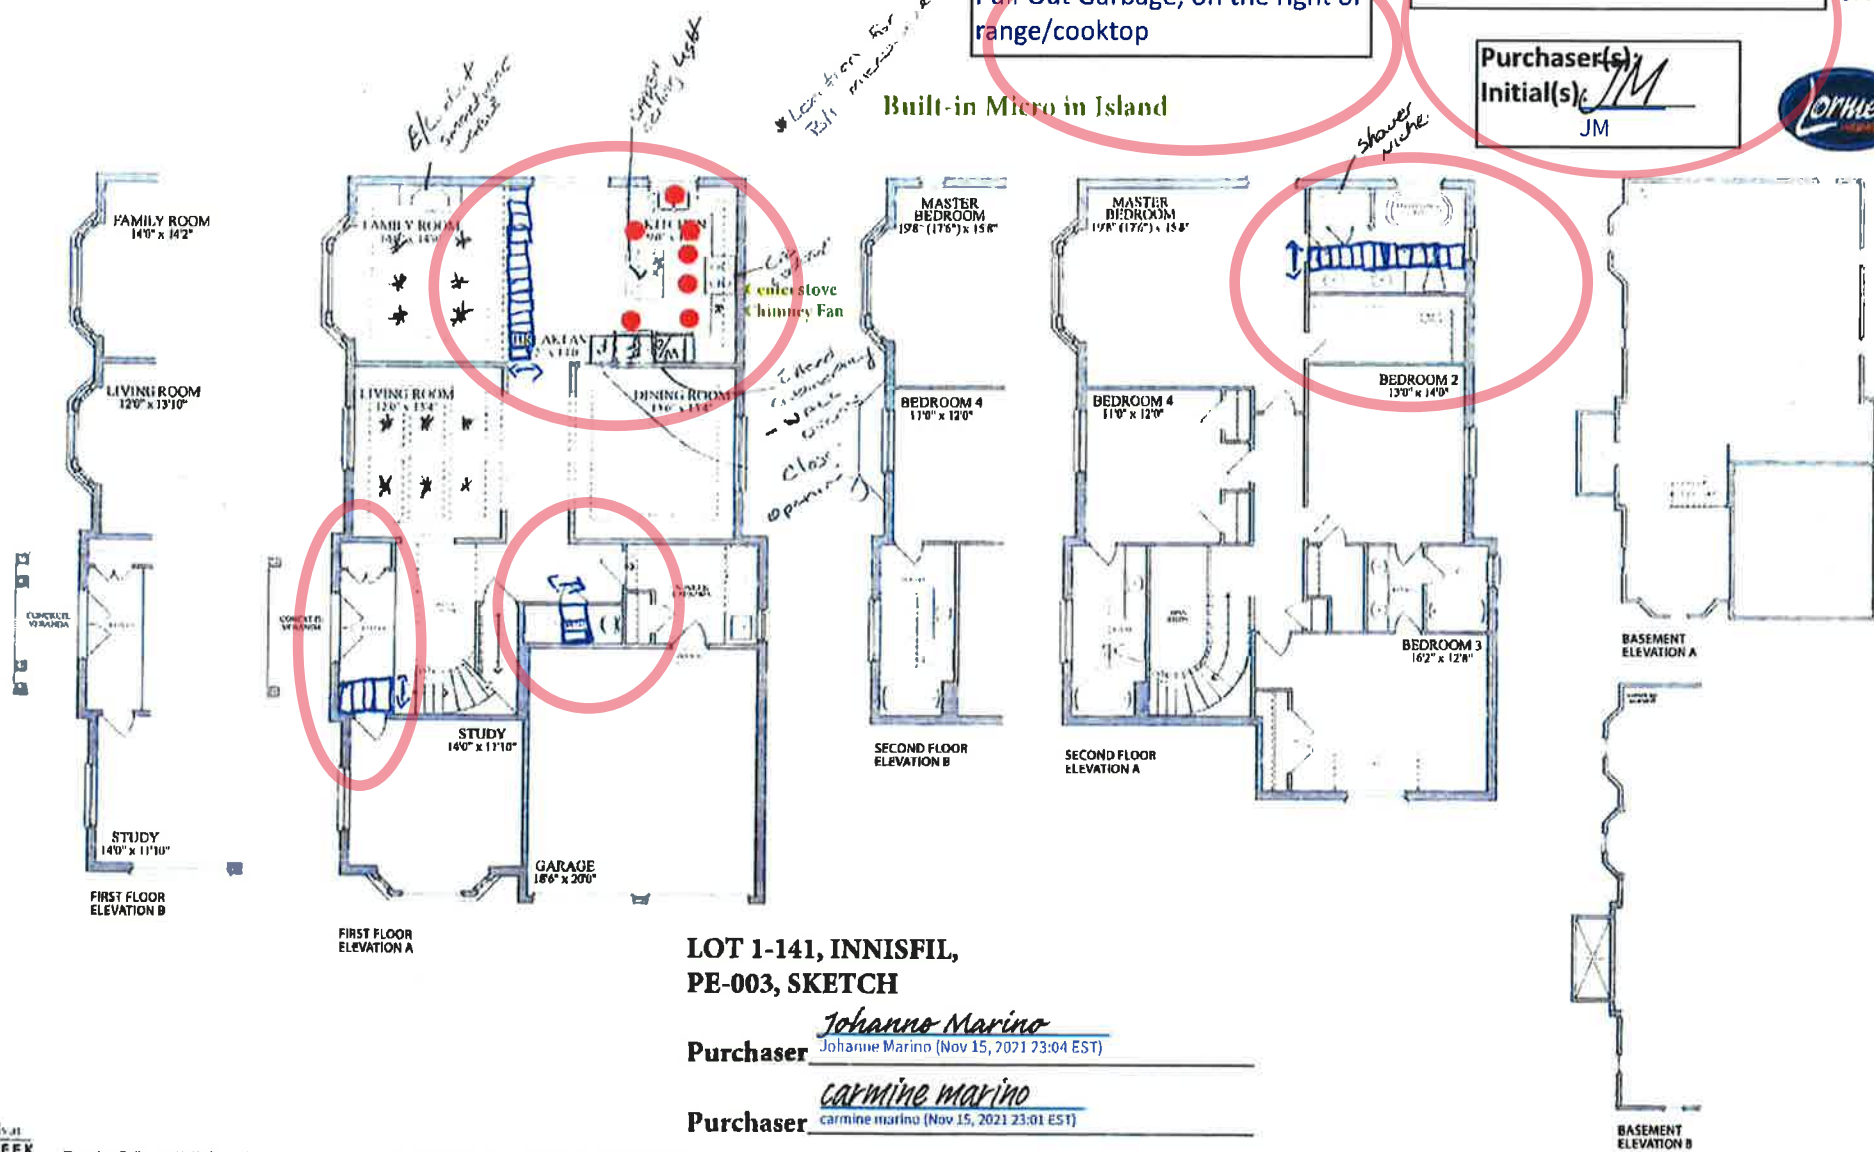

LOT 1-141, INNISFIL,
PE-003, SKETCH

Purchaser Johanne Marino
Johanne Marino (Nov 15, 2021 23:04 EST)

Purchaser Carmine Marino
carmine marino (Nov 15, 2021 23:01 EST)