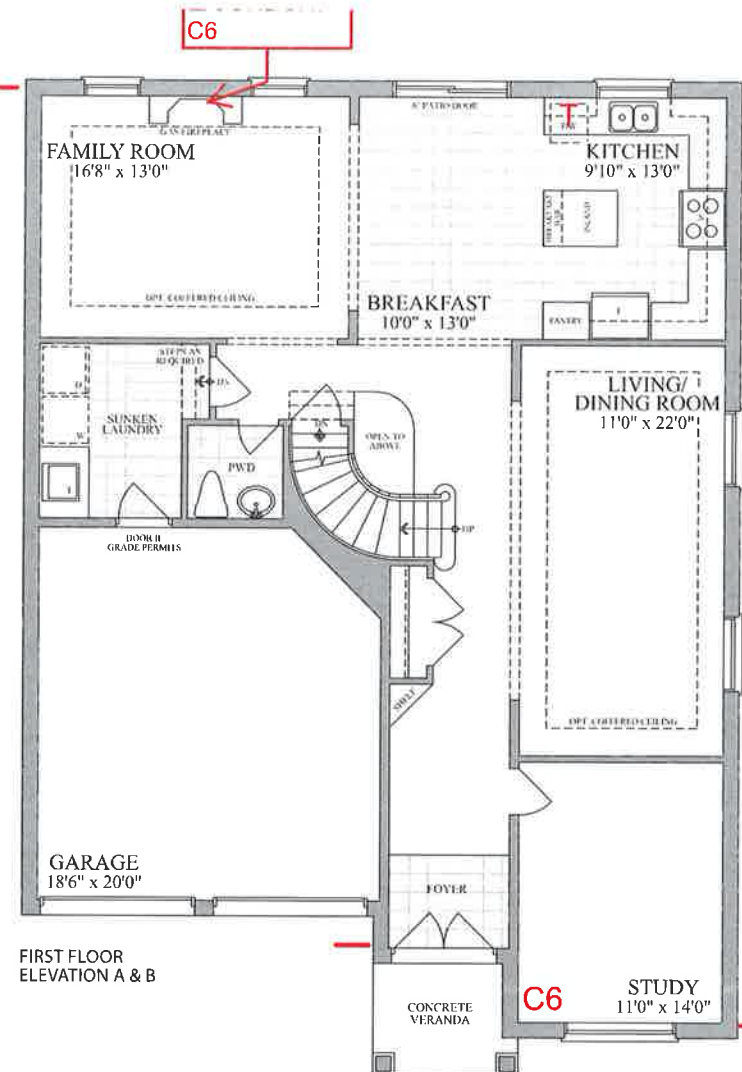
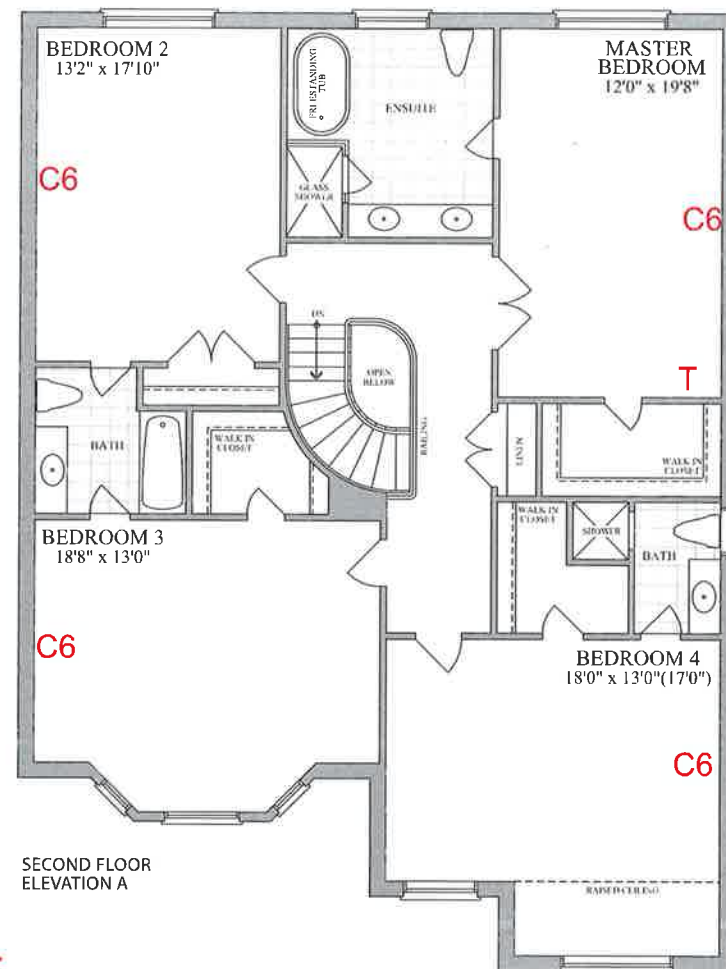
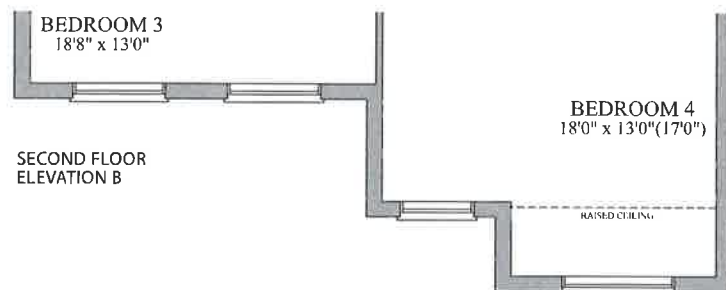
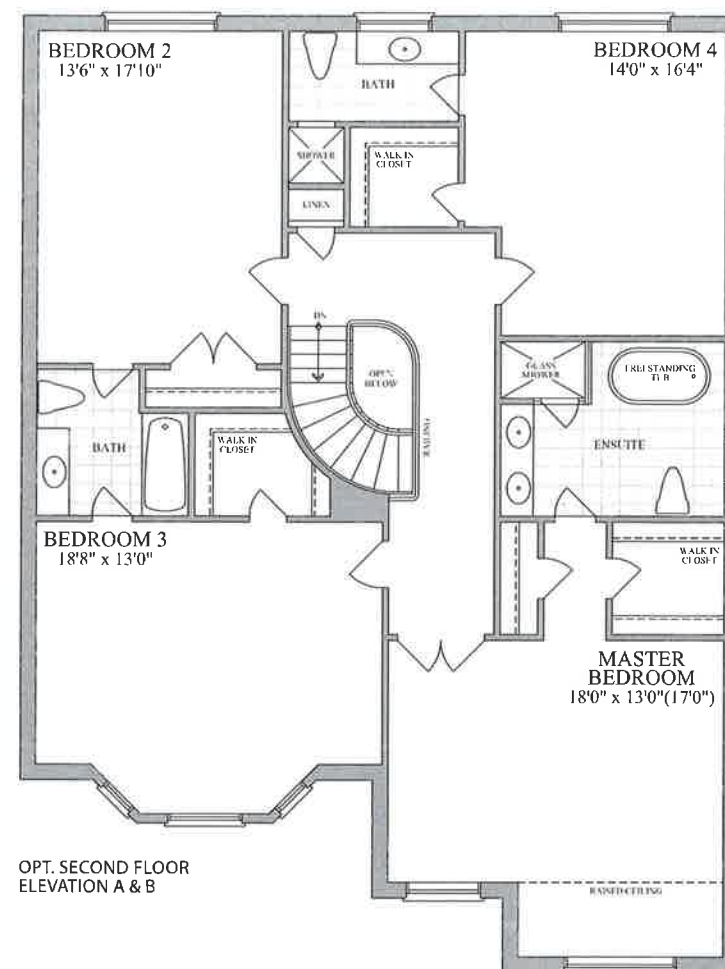



FIRST FLOOR
ELEVATION A & B

Please indicate the location of the rough-ins on your plan

Description	Symbol on Sketch	Standard Locations
Cable (Rough-in)	C	Family room Or Great Room, all bedrooms, Study/Den/Computer, (as per model)
Cat5	C5	A Cat5 wire can replace the rough-in cable at no additional cost.
Cat6	C6	Upgrade - \$50 per location
Telephone (Rough-in)	T	Kitchen and Primary Ensuite
Smart-Wire (Cat5)	S	Can be installed a Purchaser's desired location

SECOND FLOOR
ELEVATION ASECOND FLOOR
ELEVATION BOPT. SECOND FLOOR
ELEVATION A & B

LOT # **2-67**
PURCHASER: Munawar Ashraf
PURCHASER: Munawar Ashraf (Mar 24, 2022 22:13 EDT)
PURCHASER: _____

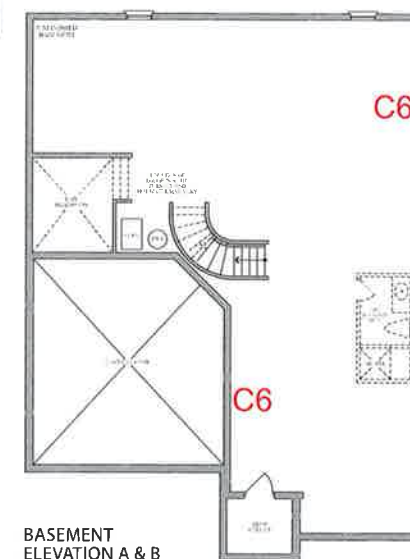BASEMENT
ELEVATION A & B