

38'
DESIGNS

The Buckhorn / Elev. A & B
1800 sq.ft.

Conduit with electrical
and tech cable



FIRST FLOOR
ELEVATION A & B


Purchaser's Initial: AL



SECOND FLOOR
ELEVATION A



SECOND FLOOR
ELEVATION B

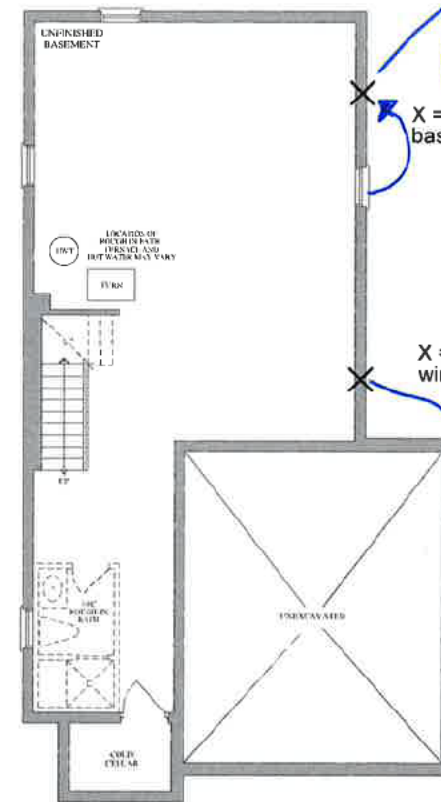

BASEMENT
ELEVATION A & B

Location
4 ft from
Rear Wall

X = Relocate standard
basement window

X = Add one (1) basement
window


Four
feet
from
corner

LOT 5-16, INNISFIL,
SKETCH, PE002



Plans and specifications are subject to change without notice. E. & O. B. All dimensions floor space may vary from the stated floor area. All renderings are artist's conceptions.


LOT 5-16, INNISFIL, SKETCH, PE002

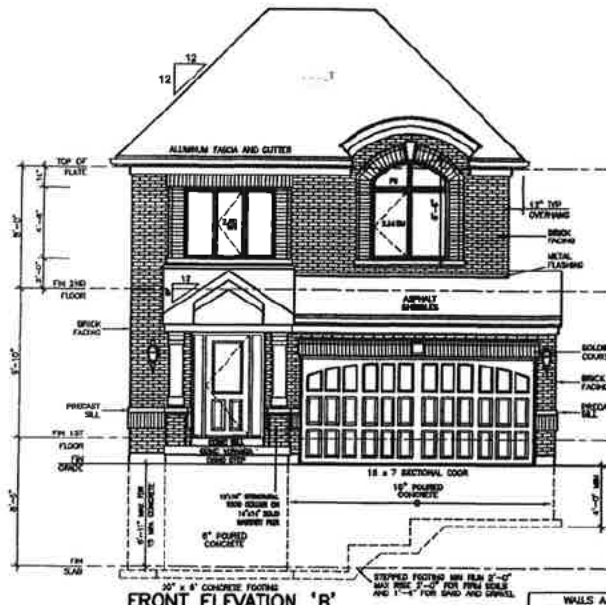


FRONT ELEVATION "B"

ELEVATION	WALL AREA	WINDOW AREA
FRONT ELEVATION	47.00 SQ. FT.	1.00 SQ. FT.
RIGHT SIDE ELEVATION	88.10 SQ. FT.	1.00 SQ. FT.
LEFT SIDE ELEVATION	88.10 SQ. FT.	1.00 SQ. FT.
REAR ELEVATION	52.00 SQ. FT.	1.00 SQ. FT.
TOTAL AREA	275.20 SQ. FT.	4.00 SQ. FT.

RIGHT SIDE ELEVATION "B"

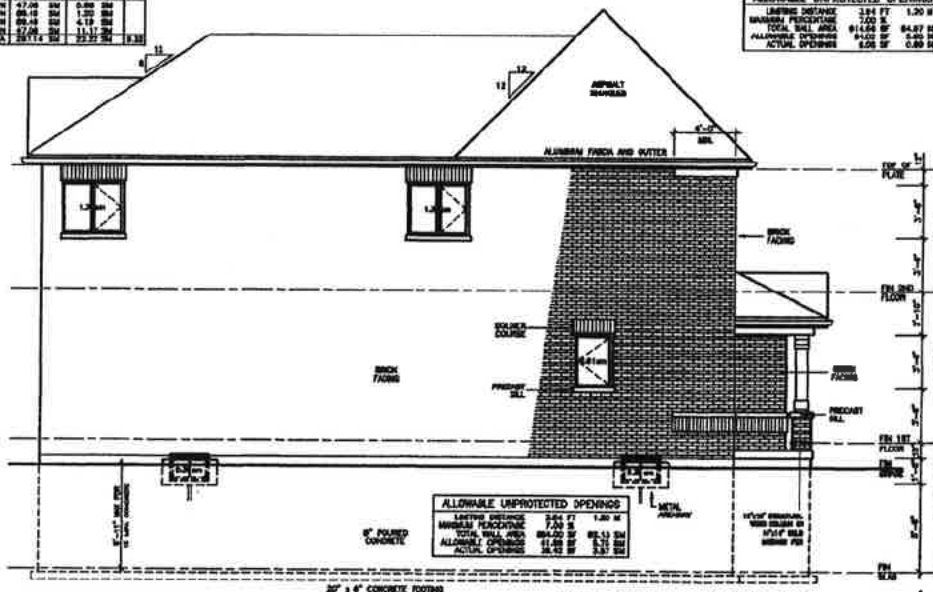

LEFT SIDE ELEVATION "B"

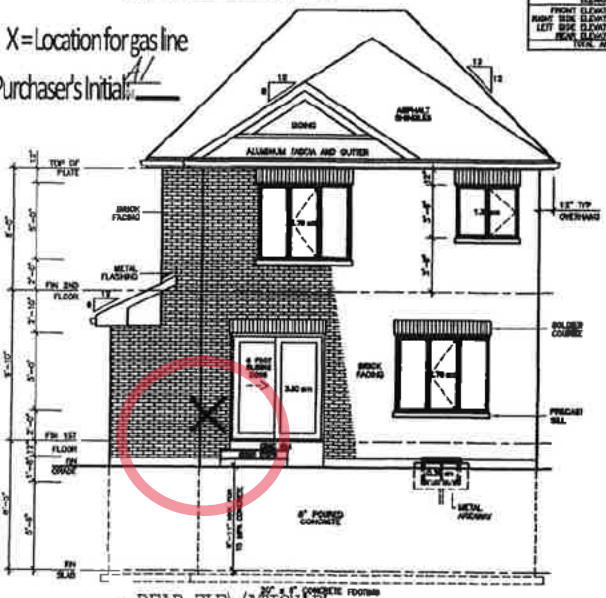

REAR ELEVATION "B"

X = Location for gas line
Purchaser's Initial: _____

REVISIONS	DATE

Lornel
HOMES

ORDINARY ASSOCIATION
OF
ARCHITECTS
100 JEFFERSON
STREET
SUITE 100
ANN ARBOR, MI 48106
734-769-1234
FAX 734-769-1235
www.lornelhomes.com

ARCHITECTURAL
DESIGN INC.

BUCKHORN
MODEL 1800

38' LOT