
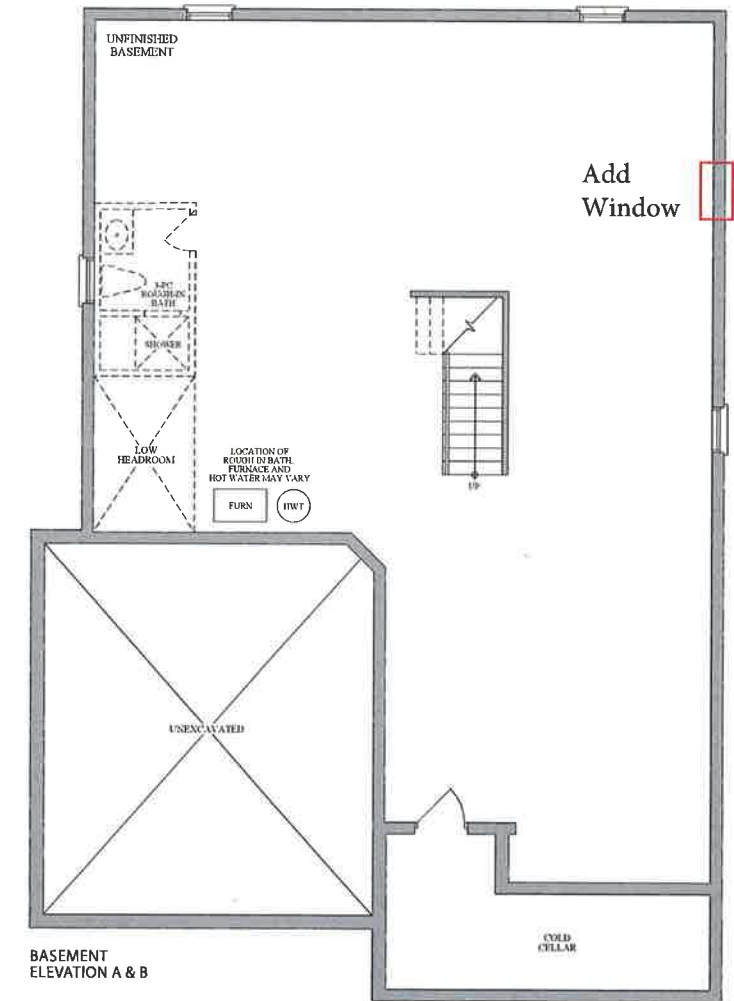
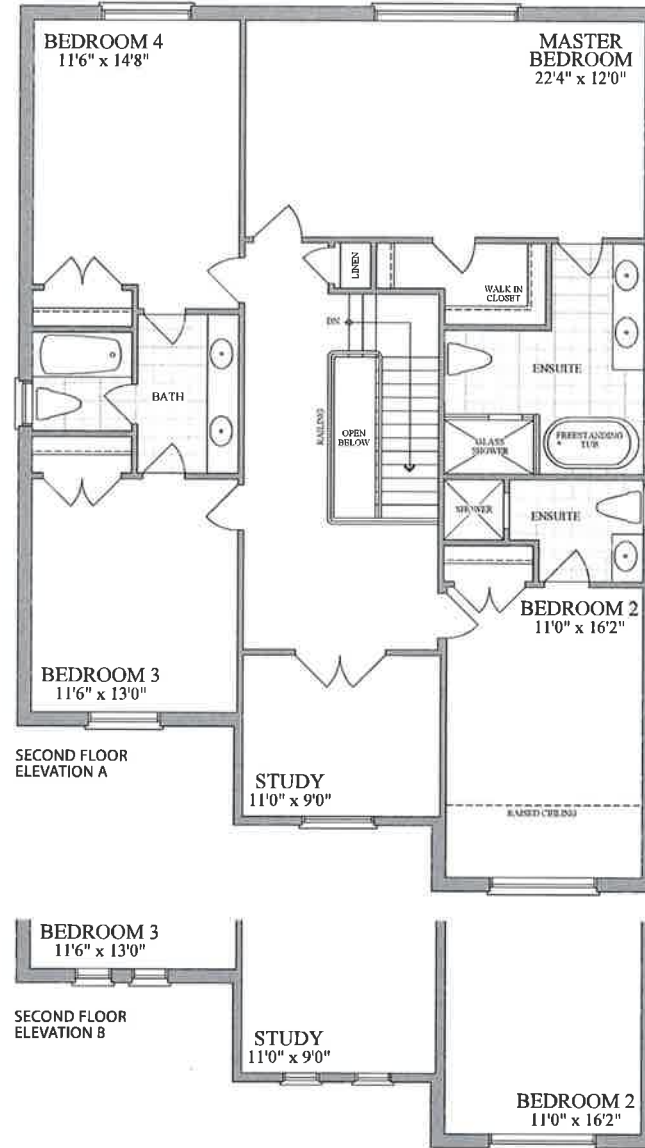


47'
DESIGNS

The **Kahshe** / Elev. A & B
3000 sq.ft.

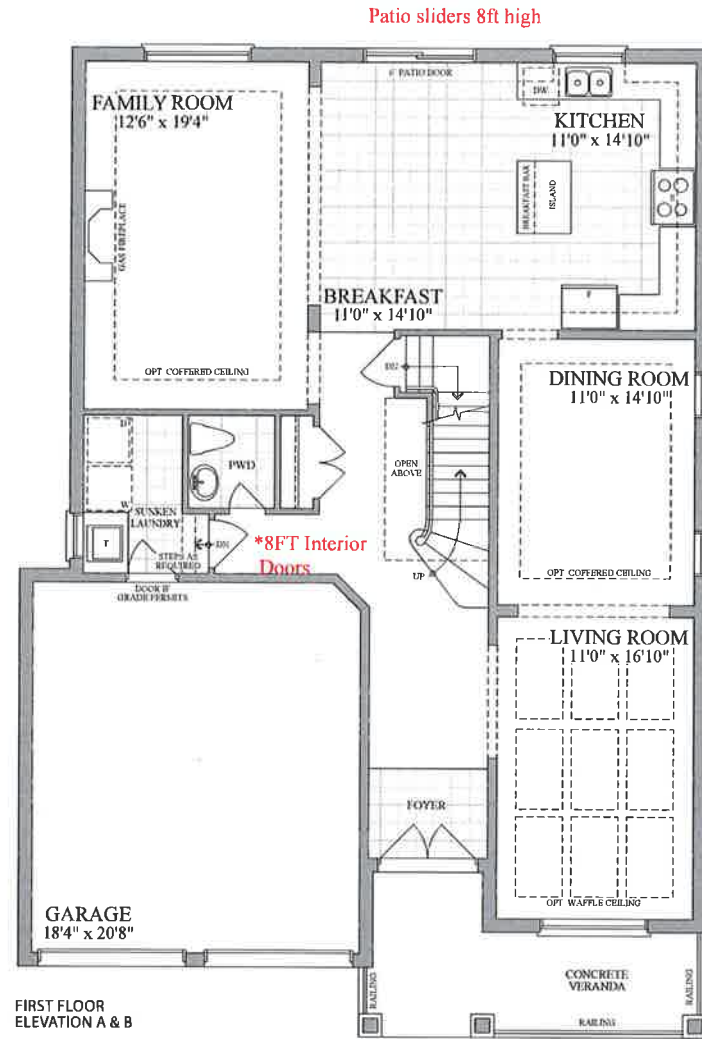

LOT 5-20, PH5, INNISFIL, PE002 SKETCH

PURCHASER: Pritpal Bhogal
(Dec 9, 2021 13:20 EST)