

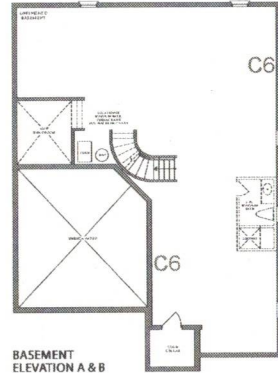
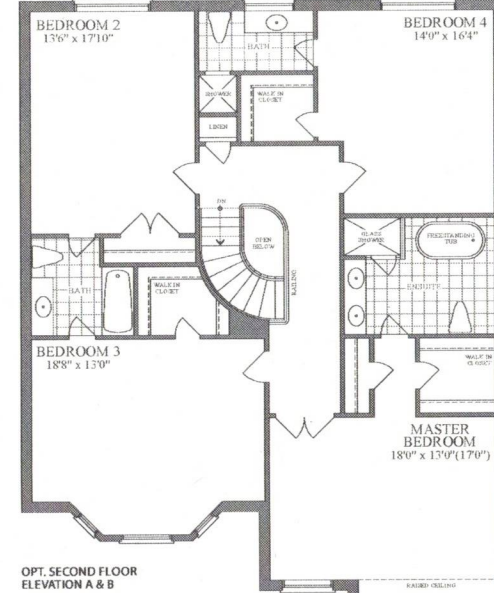


LOT 2-67, PH2, ROUGH- IN CABLE AND CAMERA LOCATIONS

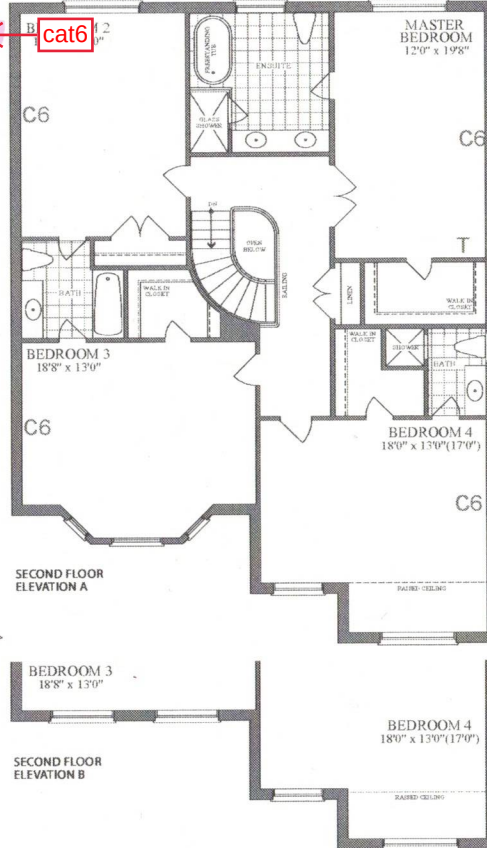

47'
DESIGNS

The nipissing / Elev. A & B
3210 sq.ft.

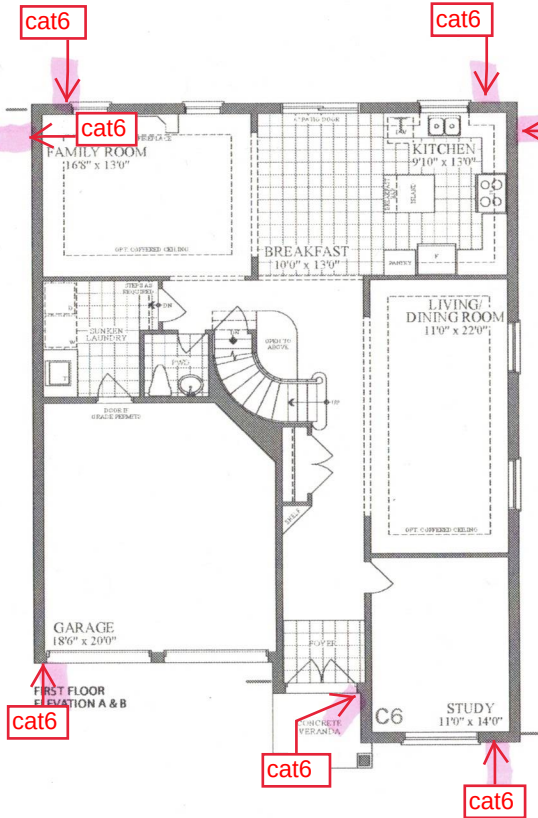

LOT # 2-67
PURCHASER: Munawar Ashraf
PURCHASER: _____



Plans and specifications are subject to change without notice. E & O E. Actual usable floor space may vary from the stated floor area. All renderings are artist's concept.