
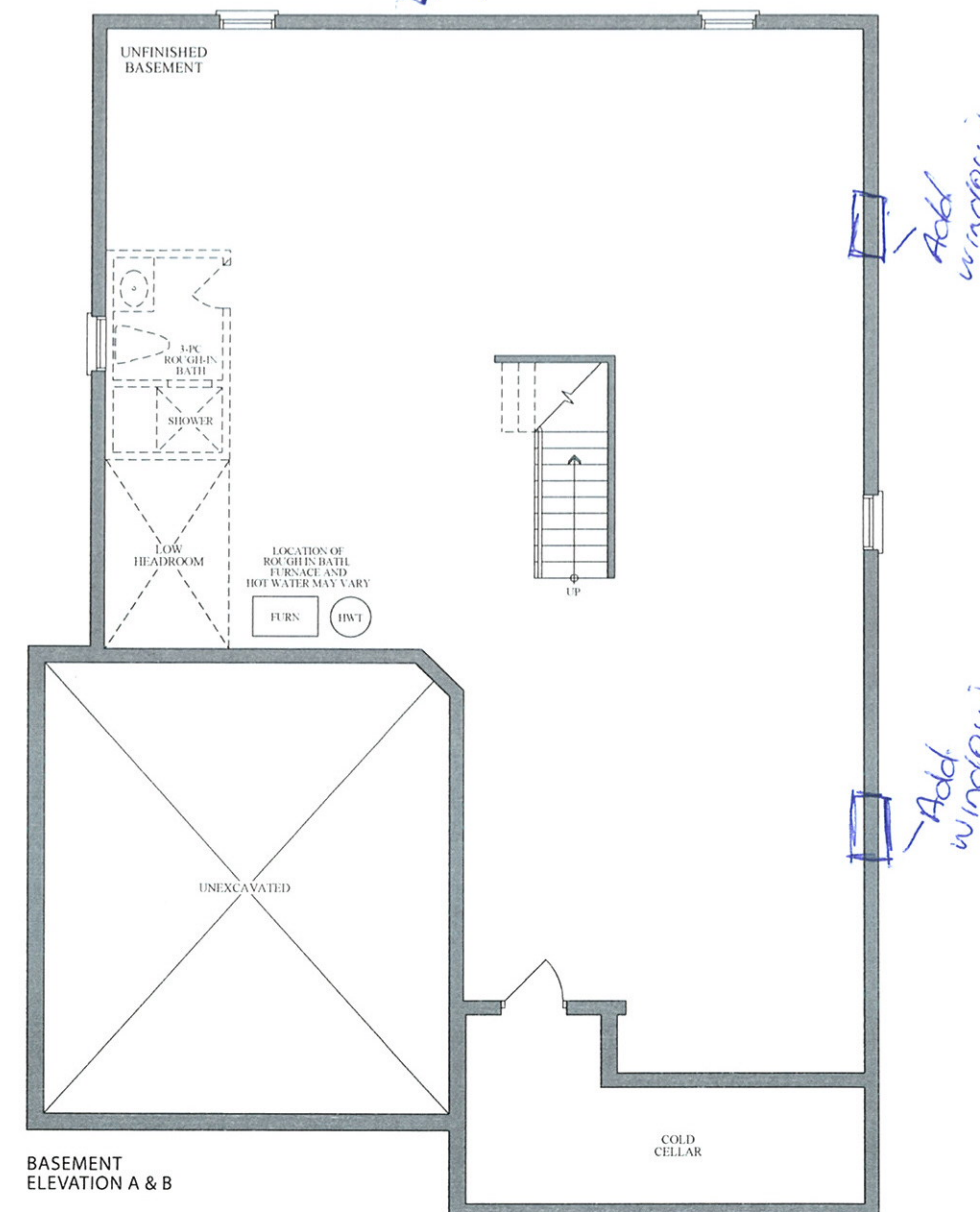
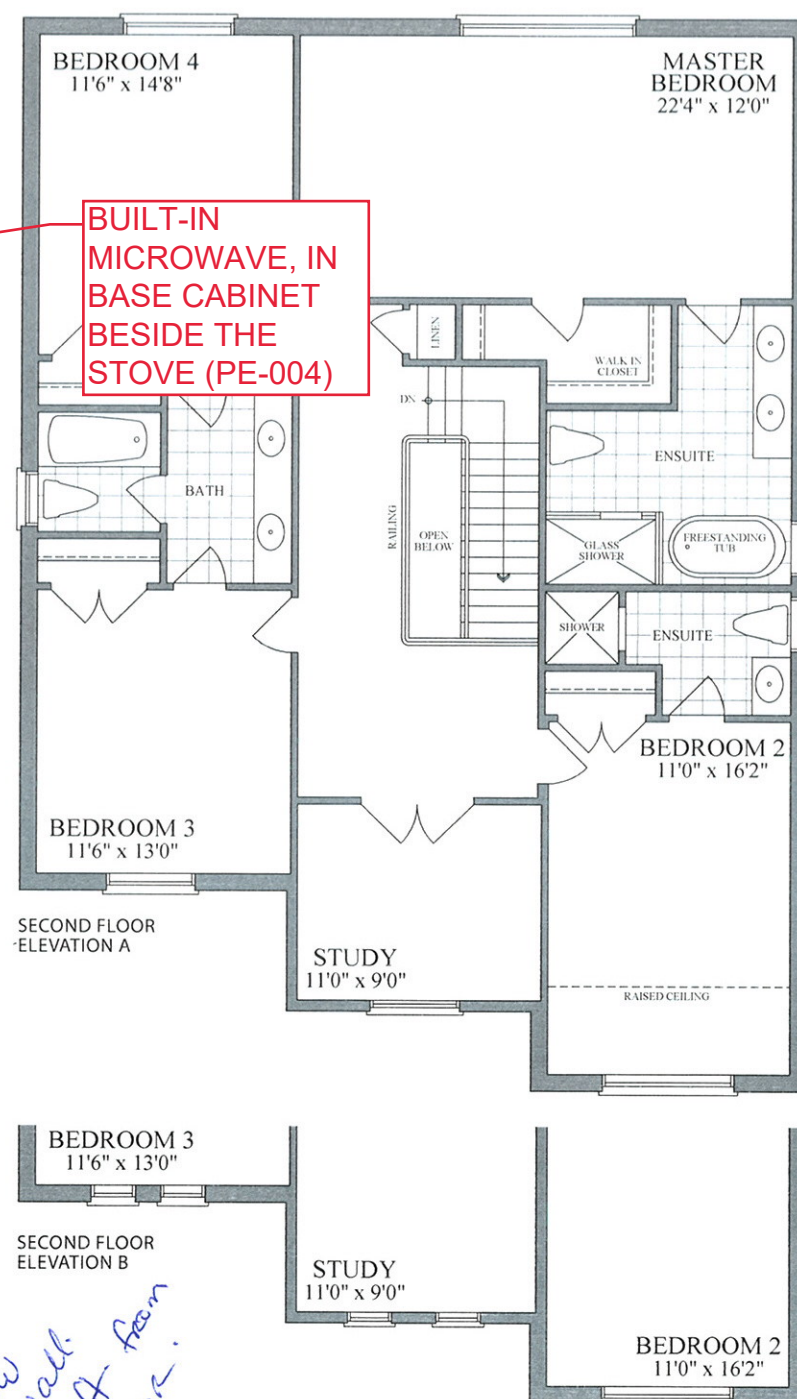


47'  
DESIGNS

The Kahshe / Elev. A & B  
3000 sq.ft.

Lot 1-180 PE #002.

\* WALK-UP  
BASEMENT.

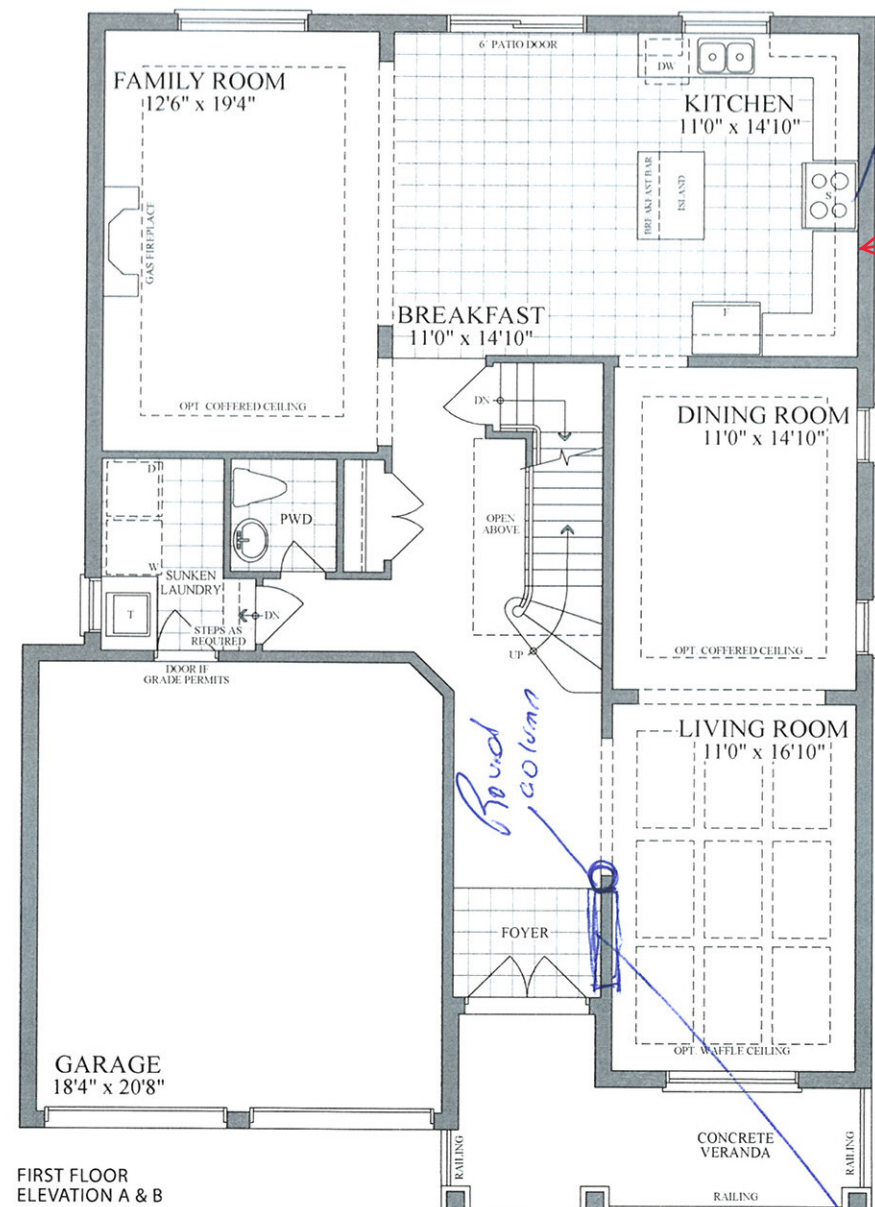

Plans and specifications are subject to change without notice. E. & O. E. Actual usable floor space may vary from the stated floor area. All renderings are artist's concept.