
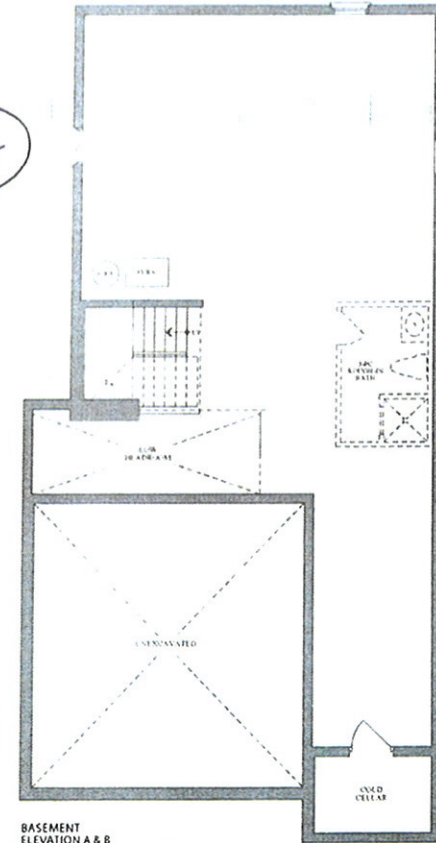
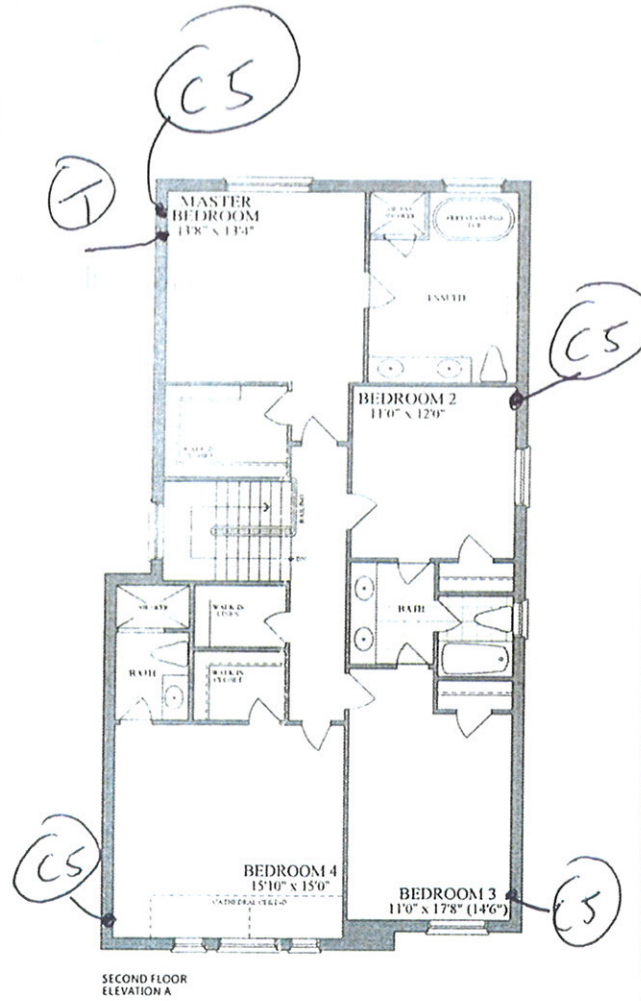


Van Viet Le
Van Viet Le (Apr 7, 2022 16:48 EDT)

38'
DESIGNS

The Finlay / Elev. A & B
2515 sq.ft.

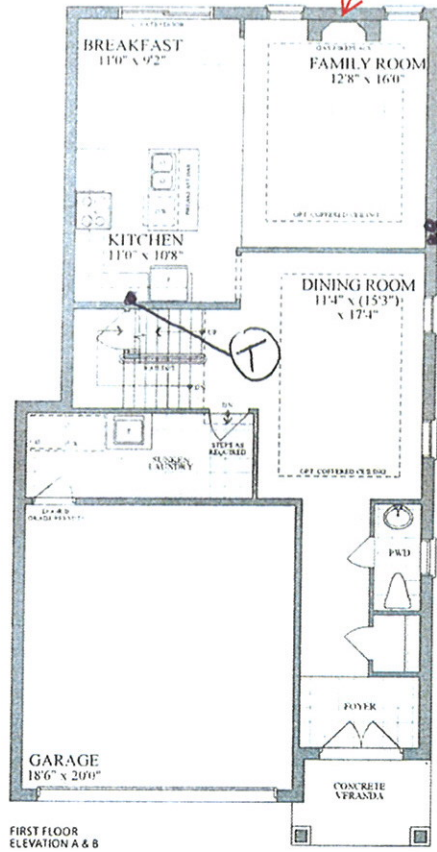

LOT #: 2-69
PURCHASER: [Signature]
PURCHASER: [Signature]

the trails at
CARSON'S CREEK

Plans and specifications are subject to change without notice. E. & G. I. E. Actual usable floor space may vary from the stated floor area. All renderings are artist's concept.

