


47'  
DESIGNS

The Carlyle / Elev. A & B  
2950 sq.ft.


C, E,  
Conduit

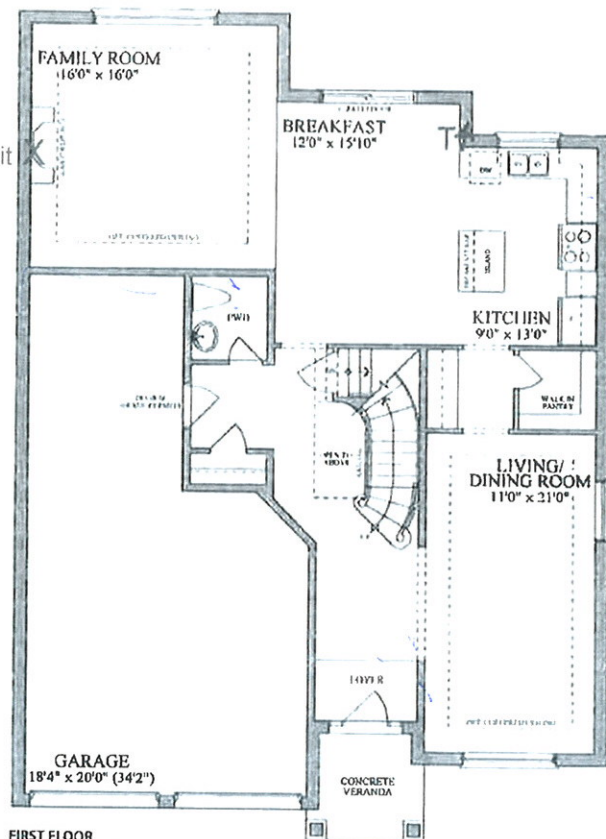

FIRST FLOOR  
ELEVATION A & B

Please indicate the location of the rough-ins on your plan

Description	Symbol on Sketch	Standard Locations
Cable (Rough-In)	C	Family room Or Great Room, all bedrooms, Study/Den/Computer, (as per model)
Cat5	C5	A Cat5 wire can replace the rough-in cable at no additional cost.
Cat6	C6	Upgrade - \$50 per location
Telephone (Rough-In)	T	Kitchen and Primary Ensuite
Smart-Wire (Cat5)	S	Can be installed at Purchaser's desired location

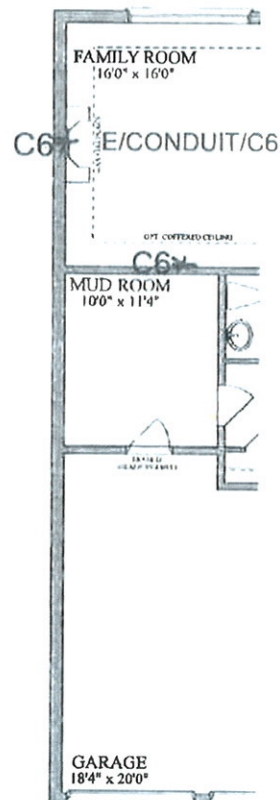


OPT. FIRST FLOOR

LOT #: 2-64


PURCHASER: *Ramona*

PURCHASER: *Prateek Arora*


*Prateek Arora*

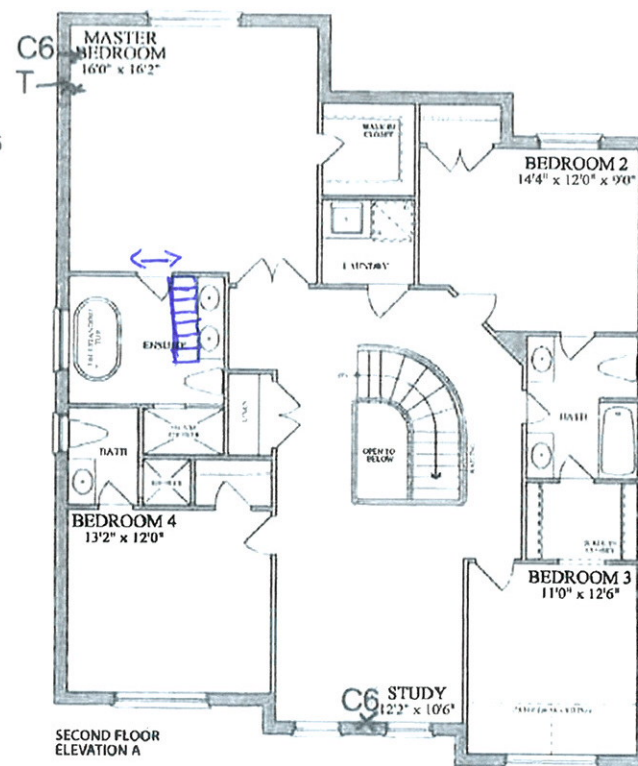

SECOND FLOOR  
ELEVATION A

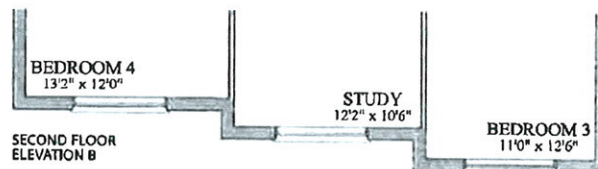

SECOND FLOOR  
ELEVATION B

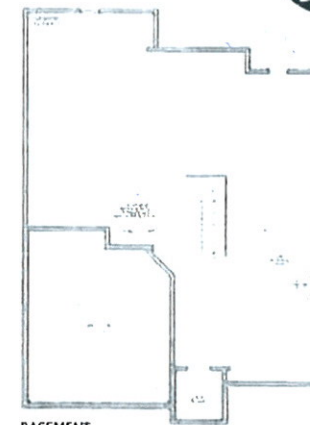

BASEMENT  
ELEVATION A



BASEMENT  
ELEVATION B



BASEMENT  
ELEVATION C



Plans and specifications are subject to change without notice. E & O E. Actual usable floor space may vary from the stated floor area. All renderings are artist's concept.