



LDT 2-30, INNISFIL, PE004

47' designs

The Madawaska / Elev. A & B
3190 sq.ft.

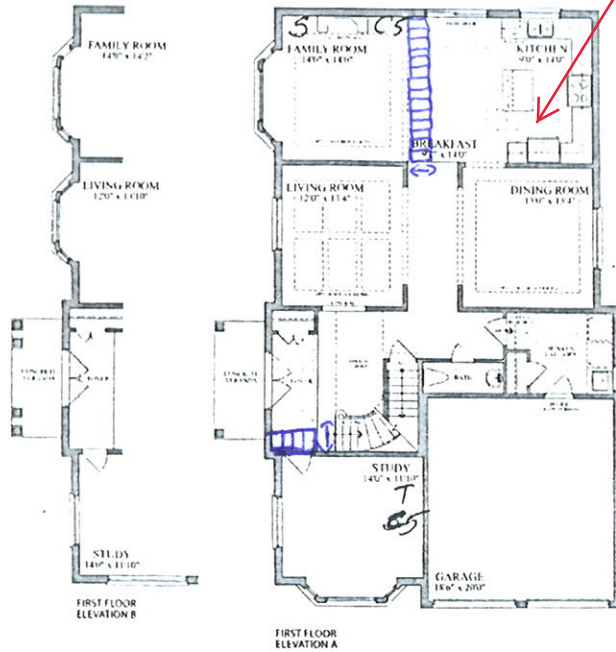

WATER FALL EDGE
ON FRIDGE SIDE

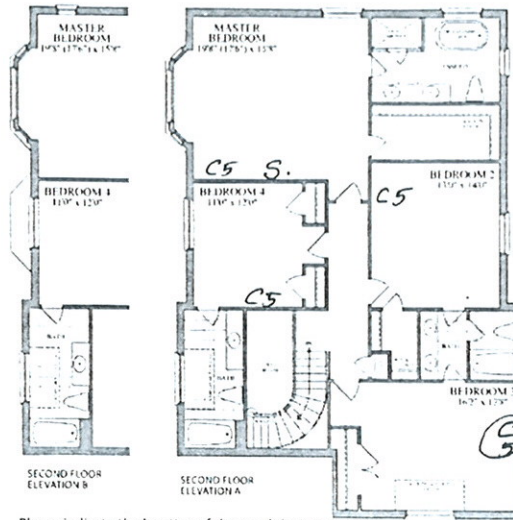

Please indicate the location of the rough-ins on your plan

Description	Symbol on Sketch	Standard Locations
Cable (Rough-in)	C	Family room Or Great Room, all bedrooms, Study/Den/Computer, (as per model)
Cat5	C5	A Cat5 wire can replace the rough-in cable at no additional cost.
Cat6	C6	Upgrade - \$50 per location
Telephone (Rough-in)	T	Kitchen and Primary Ensuite
Smart-Wire (Cat5)	S	Can be installed a Purchaser's desired location



the trails at
CARSON'S CREEK

LOT #: 30 PHASE 2

PURCHASER: JOSH Y JOB.

PURCHASER: Preethe John.

3/12/2021