
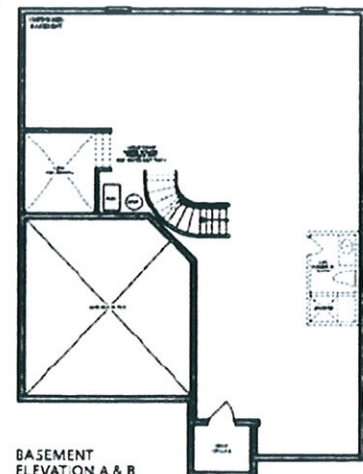
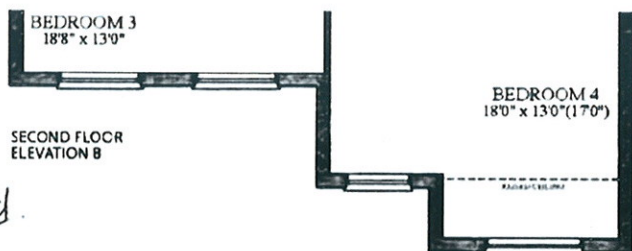
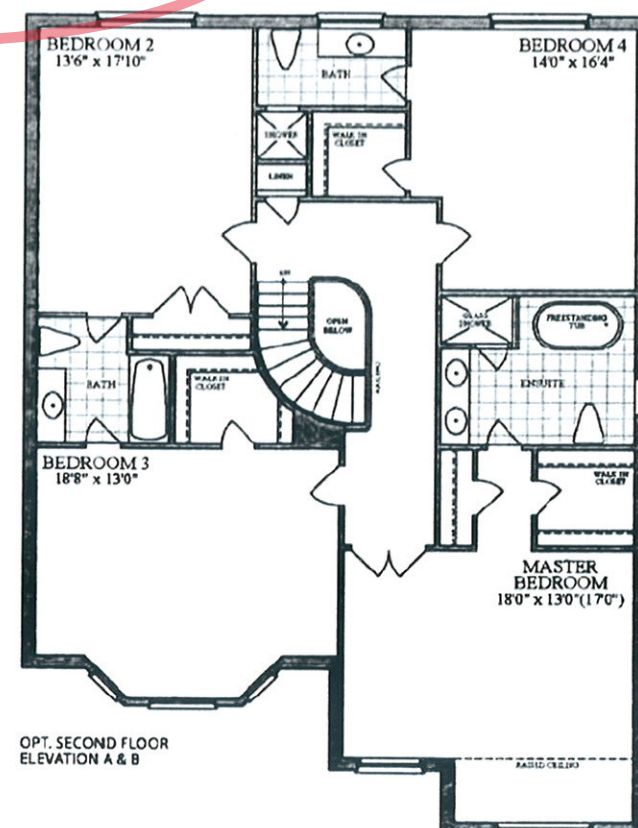
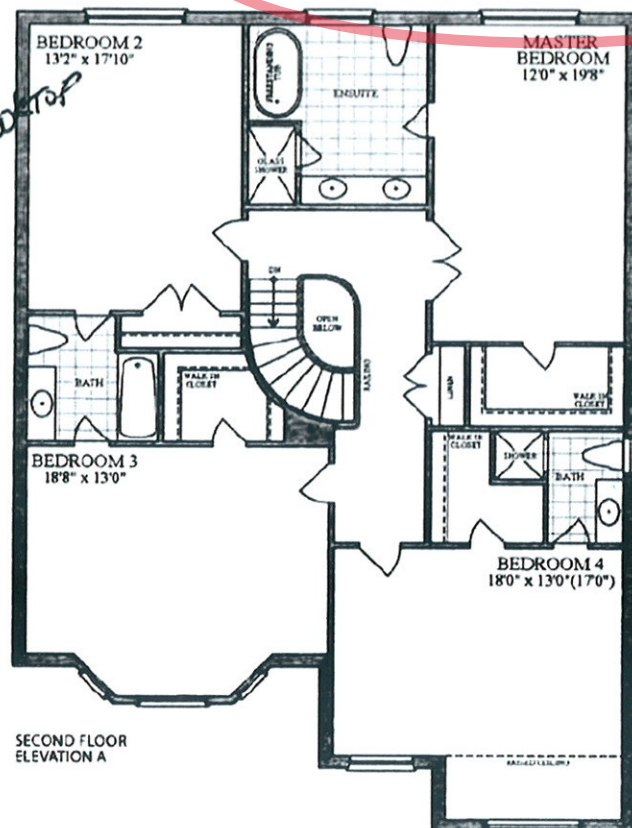


47'
DESIGNS

The nipissing / Elev. A & B
3210 sq.ft.

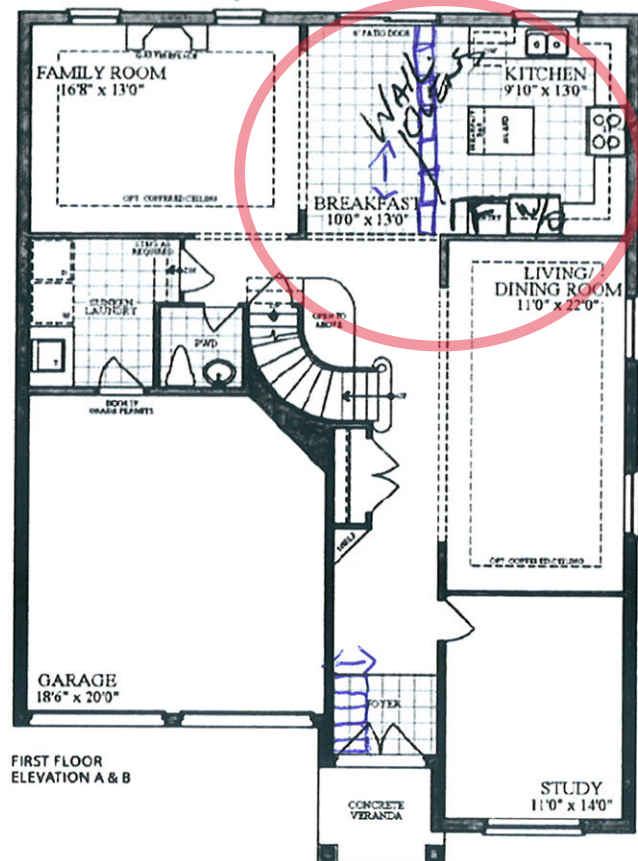

- ① Built in Appliances
- ② 10ft ceilings on main
- ③ 9ft ceiling on 2nd floor.