



38'  
DESIGNS

The manitou / Elev. A & B  
2480 sq.ft.

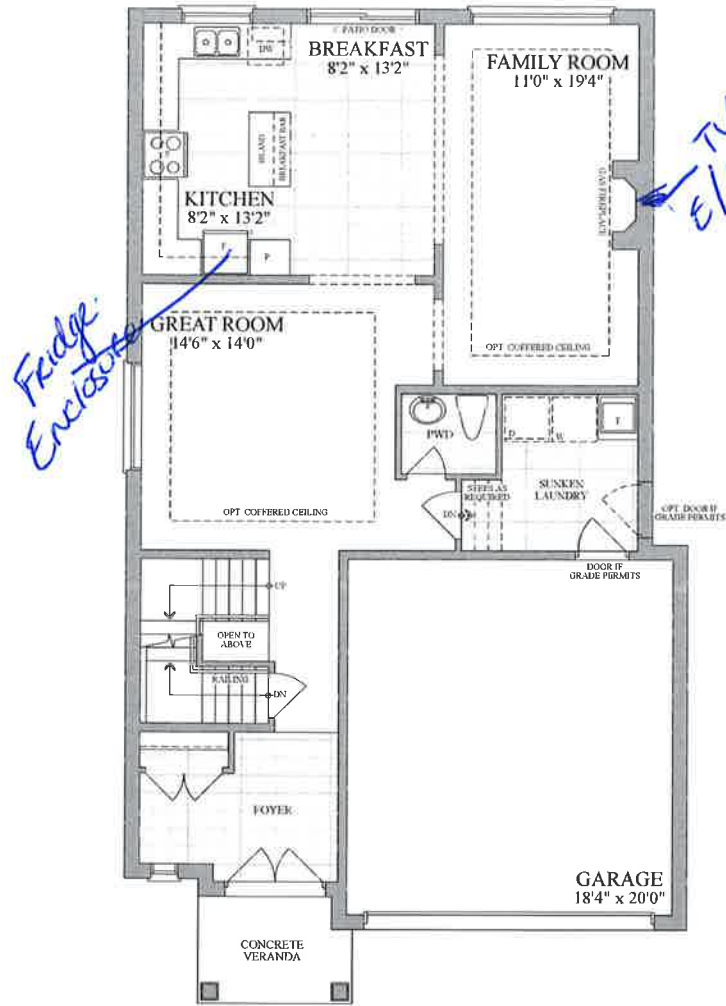


FIRST FLOOR  
ELEVATION A & B

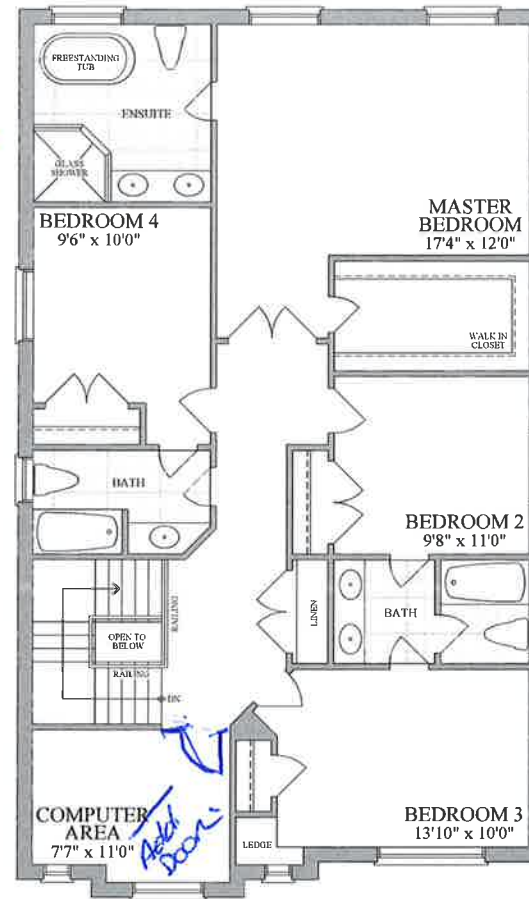

SECOND FLOOR  
ELEVATION A



SECOND FLOOR  
ELEVATION B

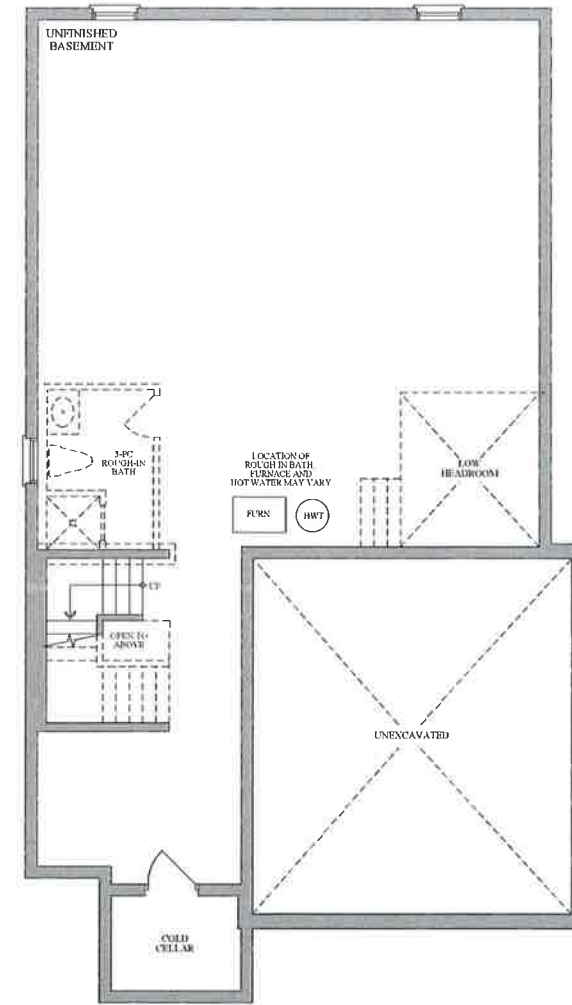

BASEMENT  
ELEVATION A & B



lot 5-31