


provision for wall
mount tv above
fireplace

the Carlyle / Elev. A & B
950 sq.ft.

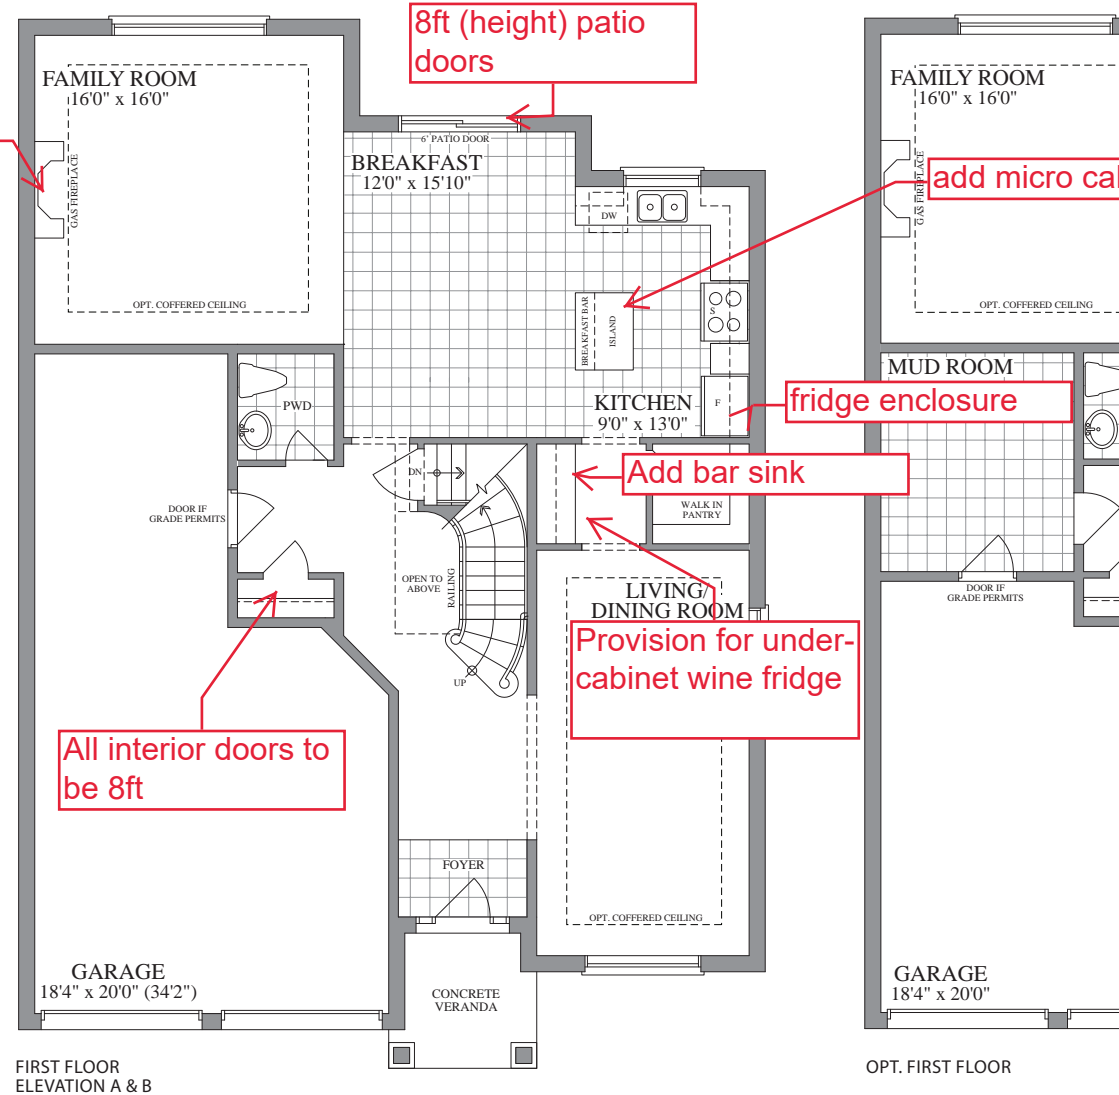

LOT 5-58, PH2, PE003, SKETCH

Purchaser: Elma Haddad (Apr 21, 2022 12:03 EDT)

