


47'
DESIGNS

The madawaska / Elev. A & B
3190 sq.ft.

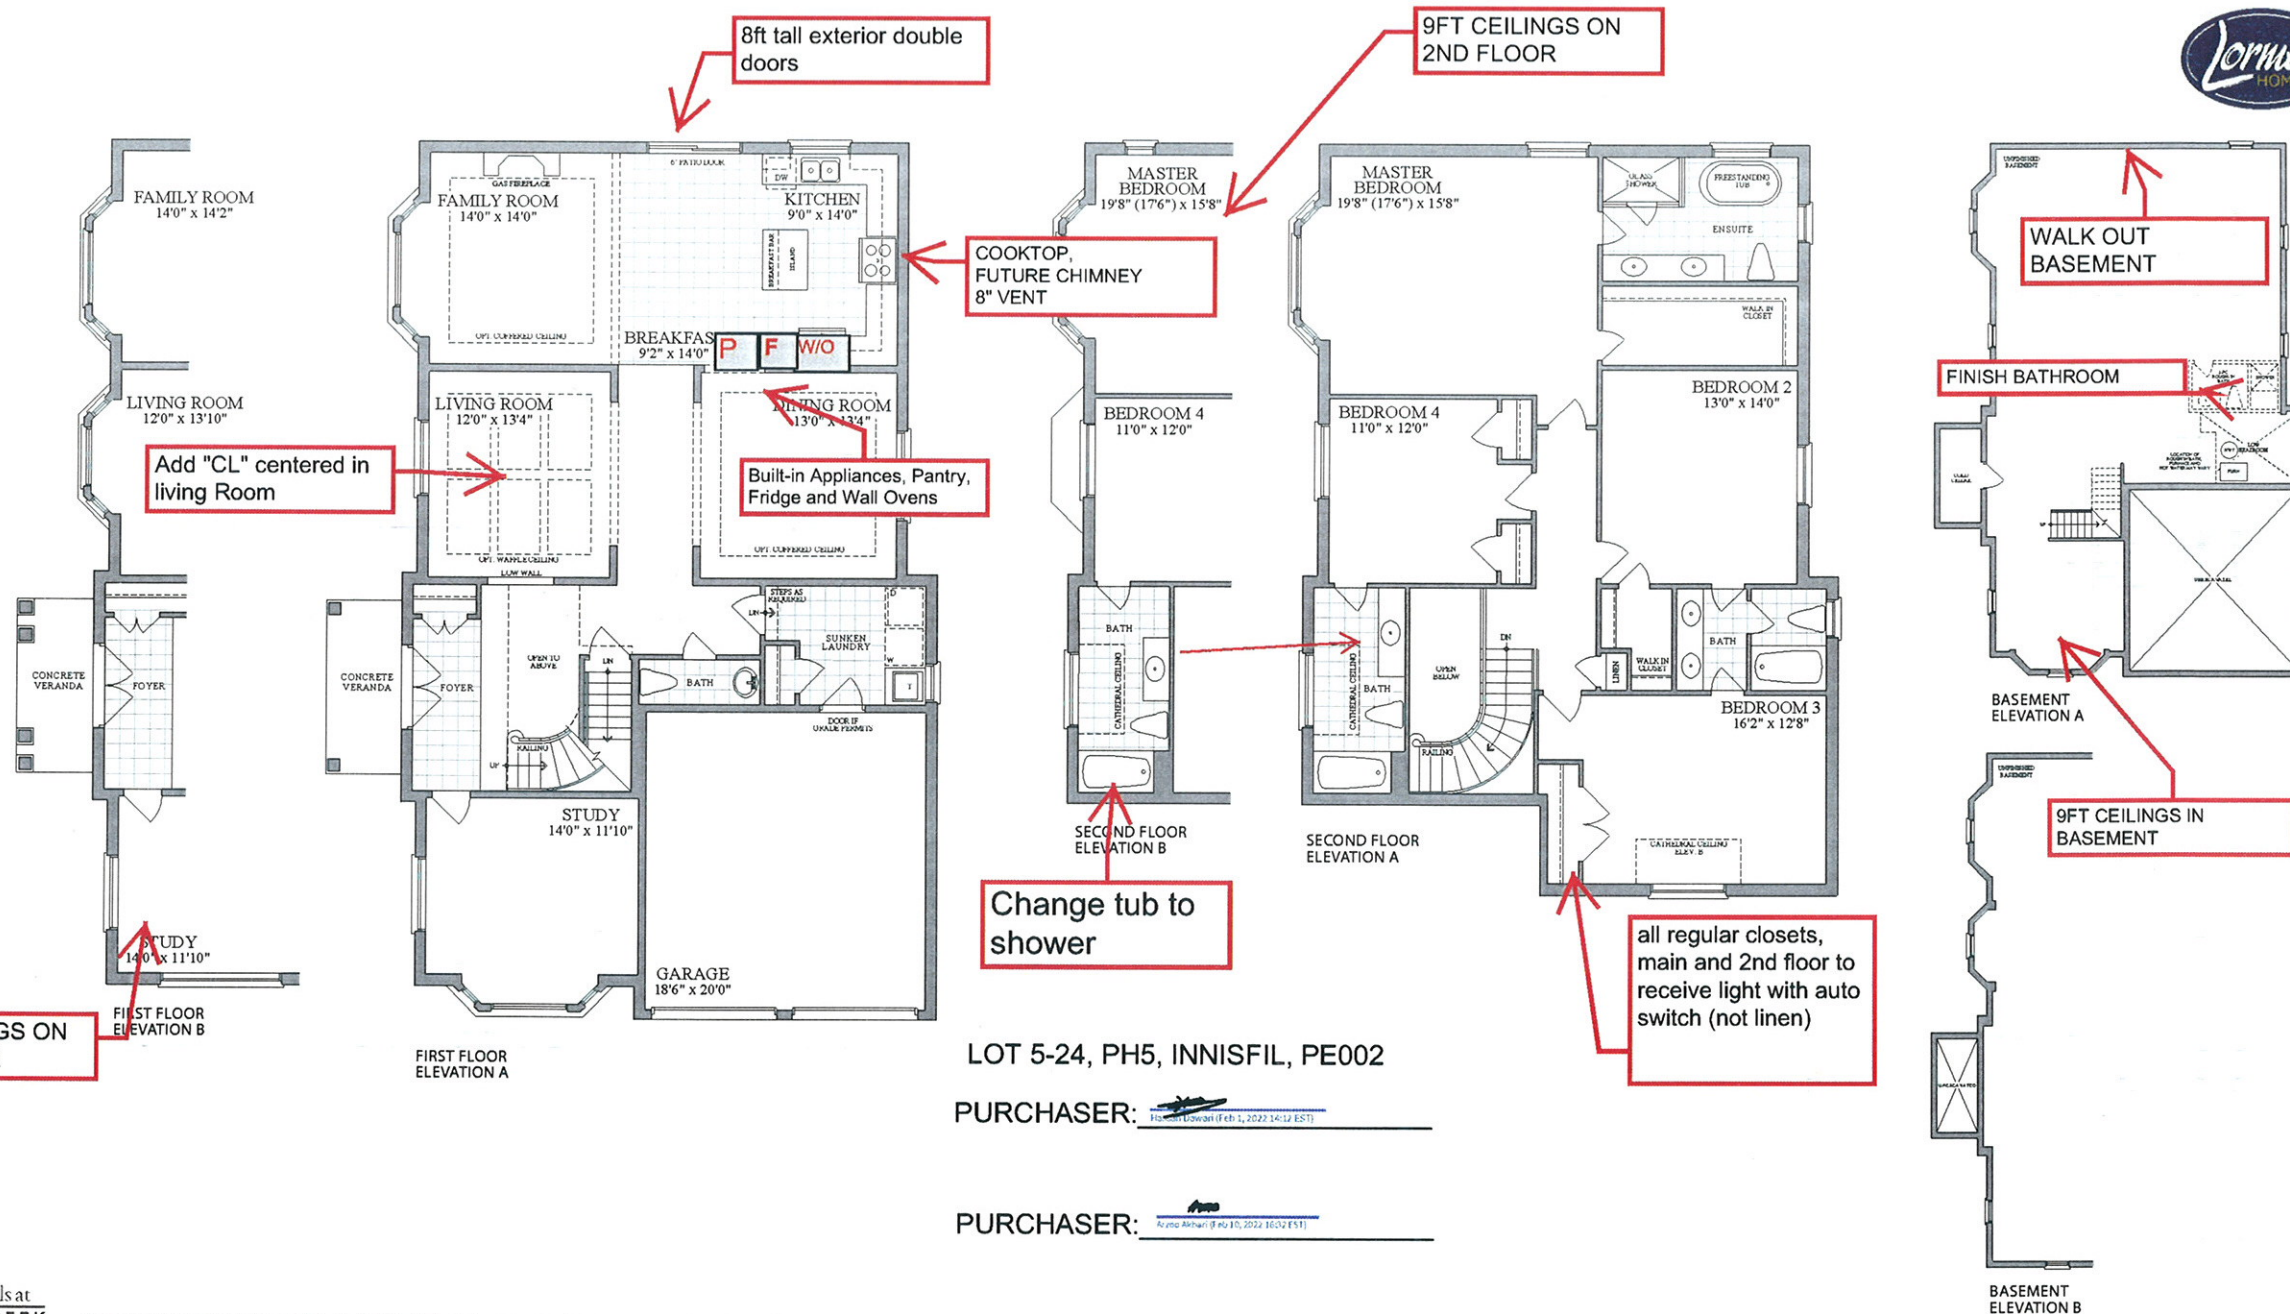

LOT 5-24, PH5, INNISFIL, PE002

PURCHASER: Hossein Lowari (ch 1, 2022 14:12 EST)

PURCHASER: Arto Arham (ch 15, 2022 16:02 EST)



Plans and specifications are subject to change without notice. E. & O. E. Actual usable floor space may vary from the stated floor area. All renderings are artist's concept.