



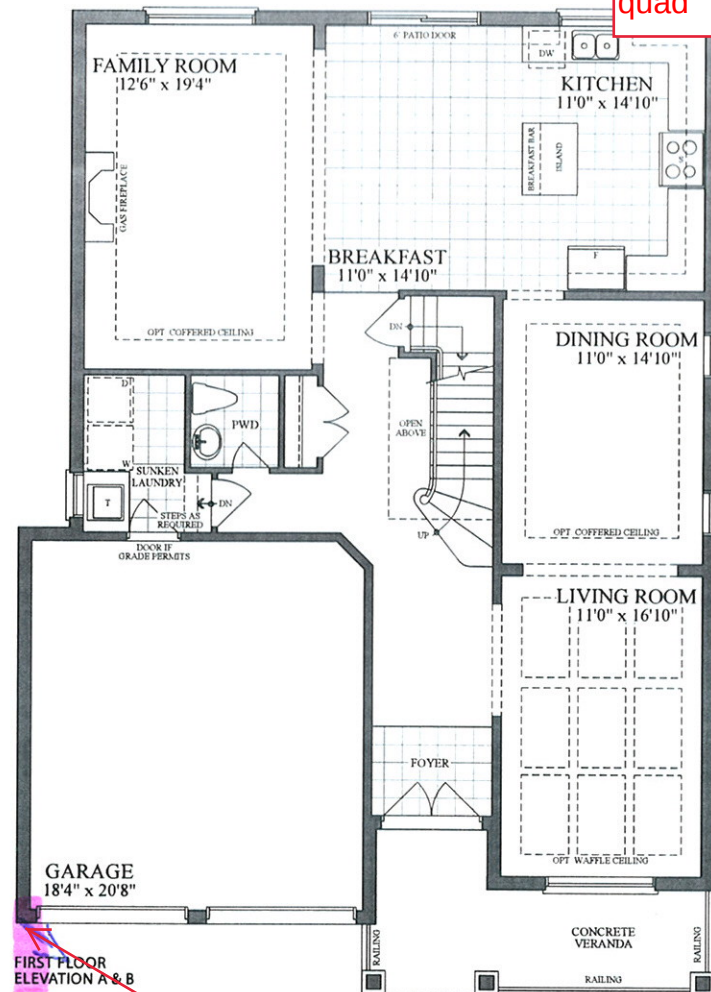


cat6 + quad
install at top
main level

cat6+
quad

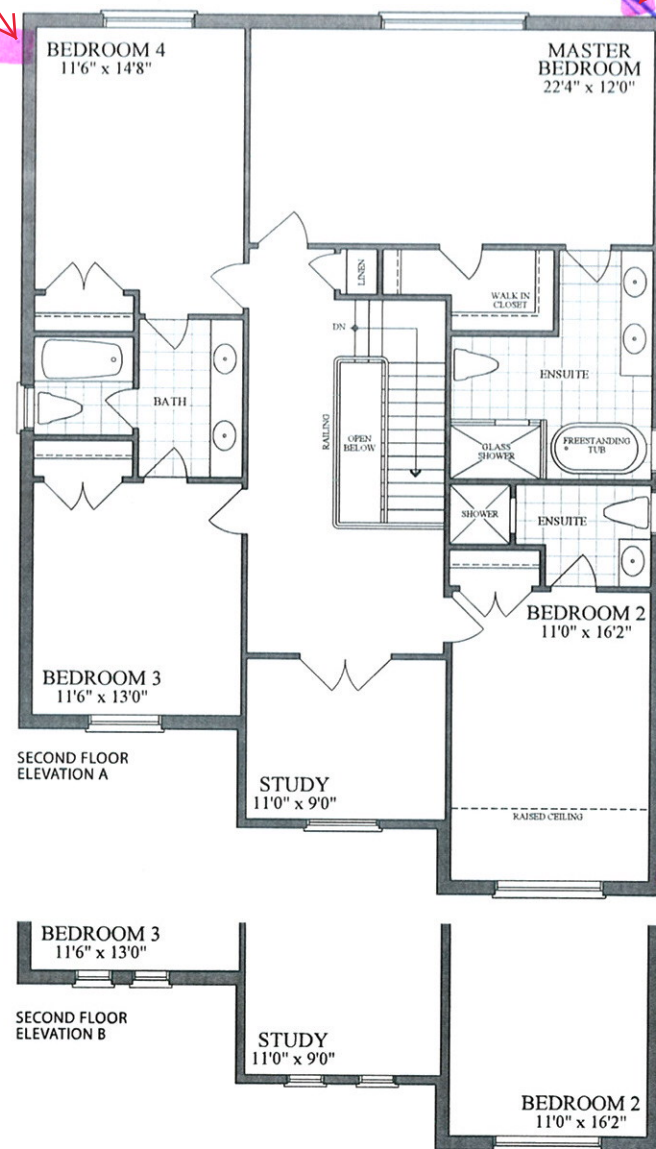

cat6 +
quad

cat6 +
quad

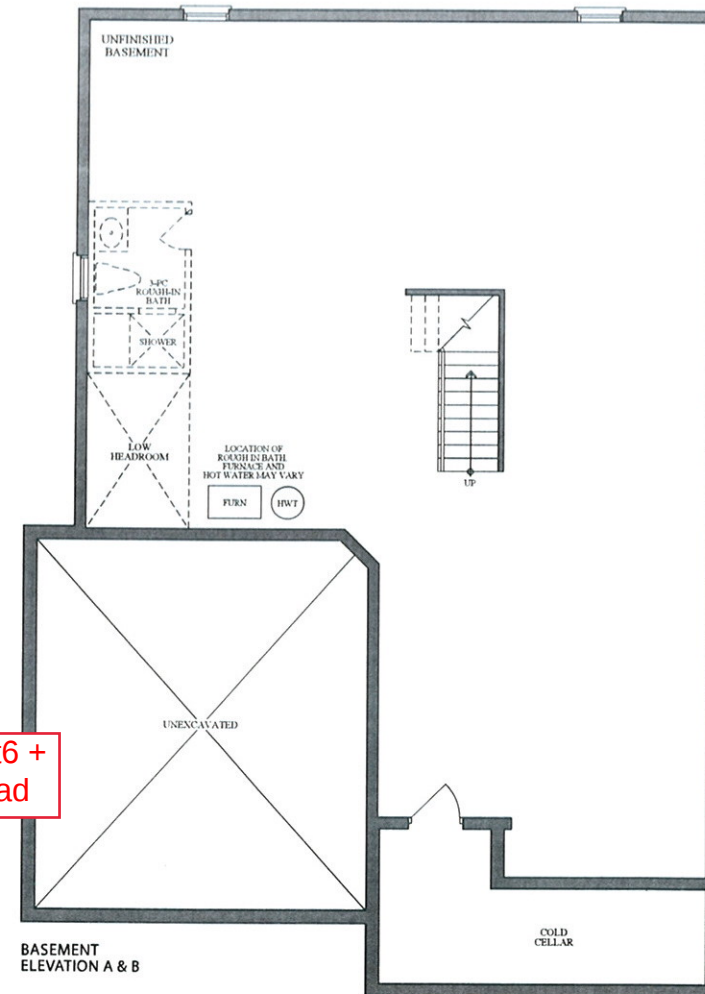

LOT 2-62: N. S. PETERSON