


LOT 1-135, INNISFIL, PE008

Purchaser's Initial: MPA

47' DESIGNS


The Madawaska / Elev. A & B
3190 sq.ft.

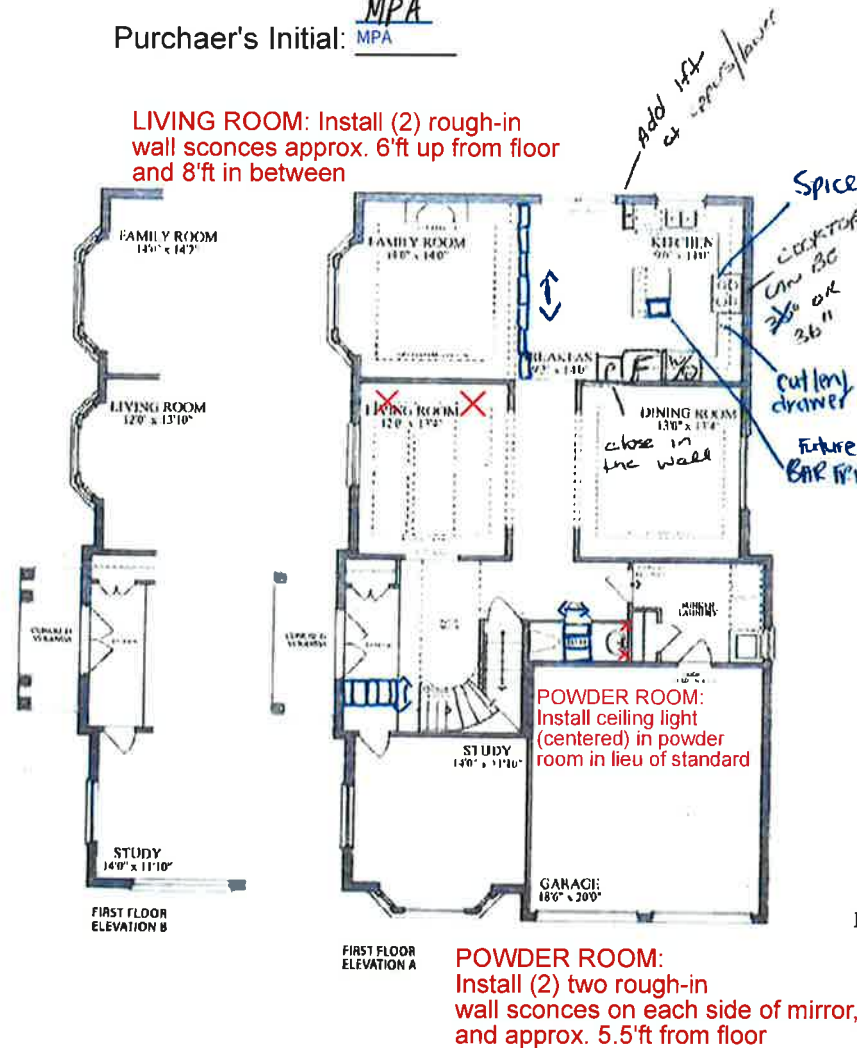

LOT 1-135, INNISFIL

LOT 1-135 - BUILT-IN APPLIANCES Purchaser's Initial: MPA

PE 006, PE 007

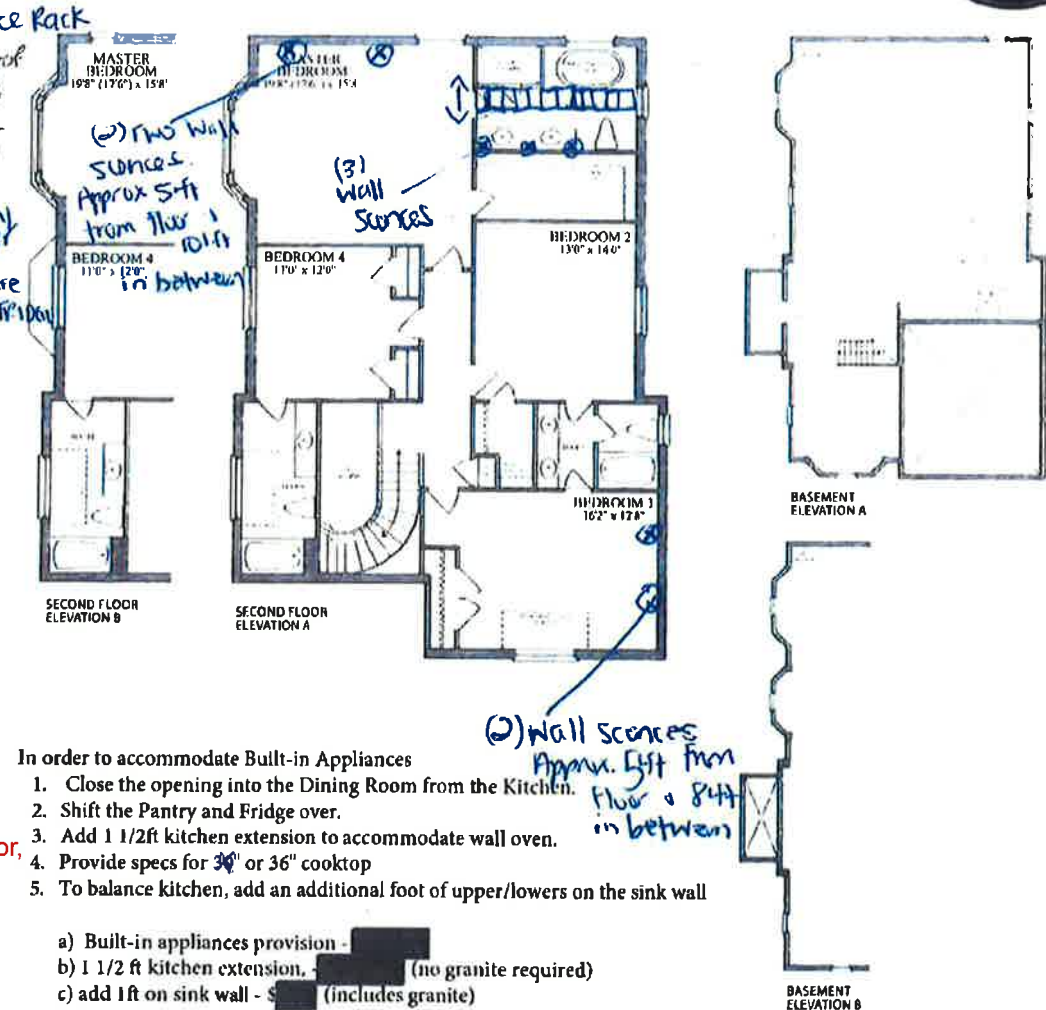

In order to accommodate Built-in Appliances

1. Close the opening into the Dining Room from the Kitchen.
2. Shift the Pantry and Fridge over.
3. Add 1 1/2ft kitchen extension to accommodate wall oven.
4. Provide specs for 36" or 36" cooktop
5. To balance kitchen, add an additional foot of upper/lowers on the sink wall

- a) Built-in appliances provision - [redacted]
- b) 1 1/2 ft kitchen extension, [redacted] (no granite required)
- c) add 1ft on sink wall - [redacted] (includes granite)

The above reflects what needs to be done in order to accommodate Built-in appliances properly.



Plans and specifications are a report to change without notice E & D. All dimensions shown are approximate and subject to change.