

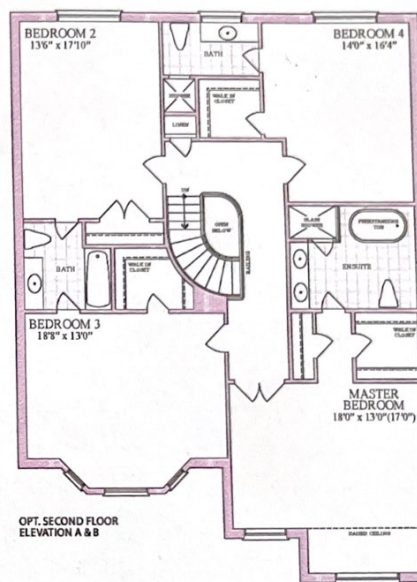


The **nipissing** / Elev. A & B
3210 sq.ft.

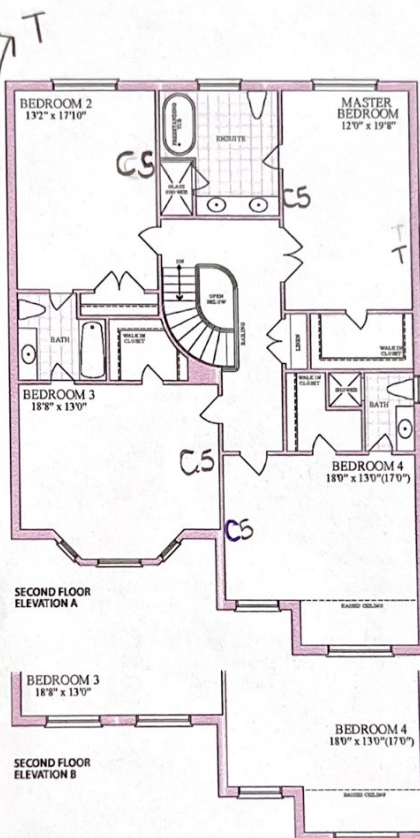

the trails at
CARSON'S CREEK


Plans and specifications are subject to change without notice. E. & O. E. Actual usable floor space may vary from the stated floor area. All renderings are artist's concept.

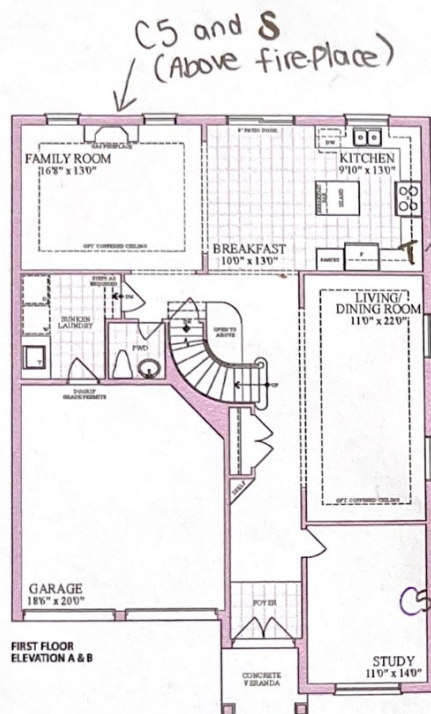

LOT # 5-80

PURCHASER: Neeraj Bali

PURCHASER: Reena Kum

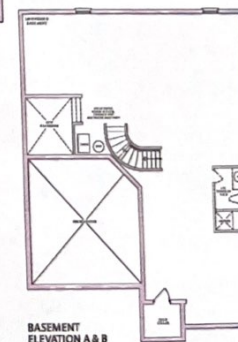

BASEMENT
ELEVATION A & B

