


38'
DESIGNS

the Manitou / Elev. A & B
2480 sq.ft.

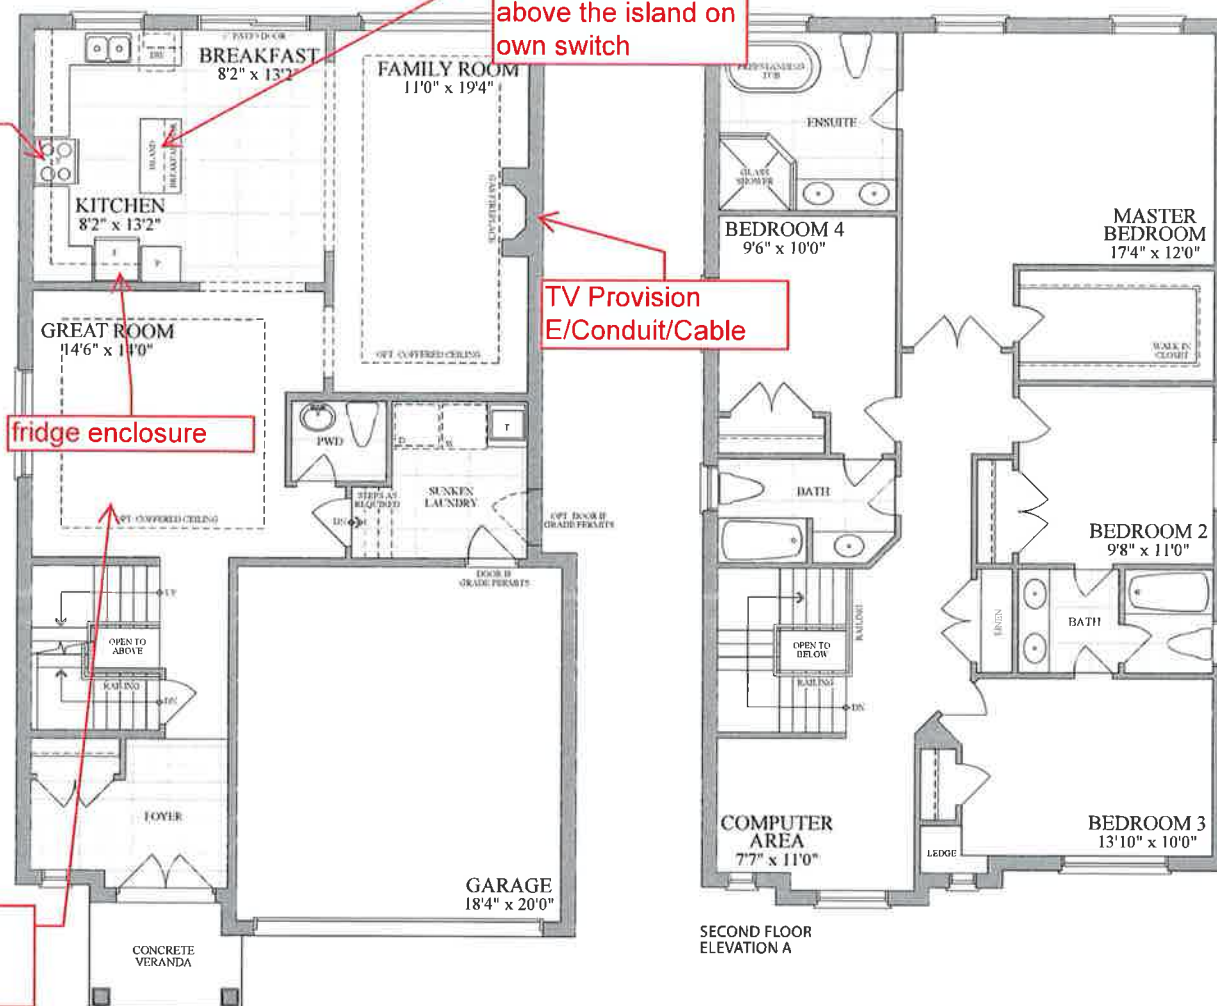


FIRST FLOOR
ELEVATION A & B

SECOND FLOOR
ELEVATION A



SECOND FLOOR
ELEVATION B

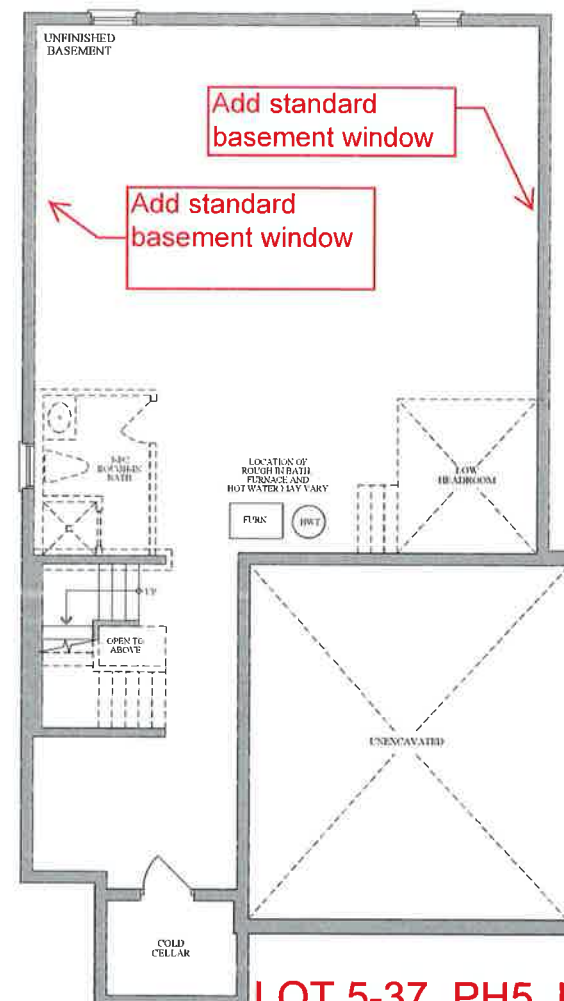

BASEMENT
ELEVATION A & B

LOT 5-37, PH5, PE002, SKETCH

Purchaser: Jaswantkthind
Jaswantkthind (May 17, 2022 14:49 EDT)

Purchaser: amarinder singh
amarinder singh (May 18, 2022 19:58 EDT)

Navjot Kaur
Navjot Kaur (May 16, 2022 15:41 EDT)