
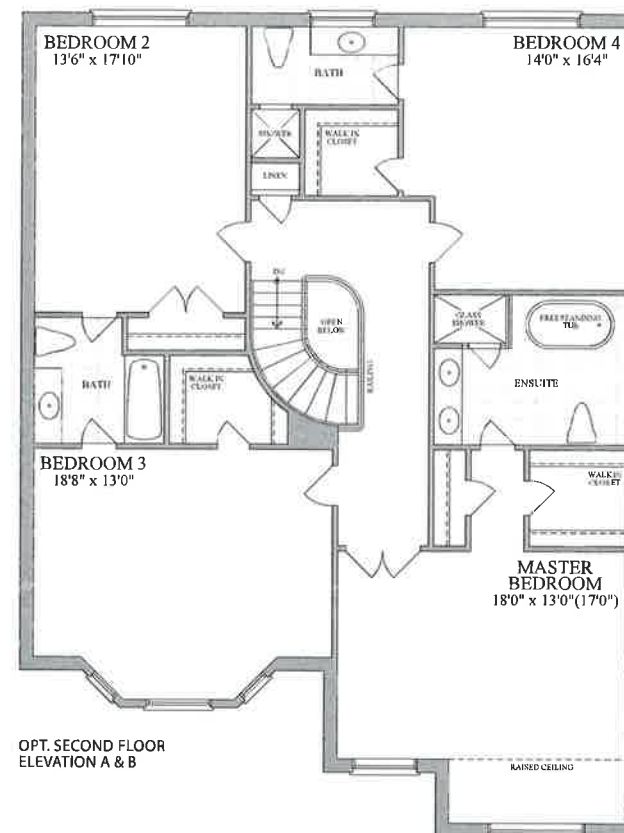
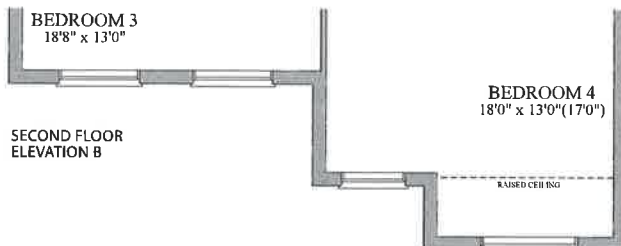
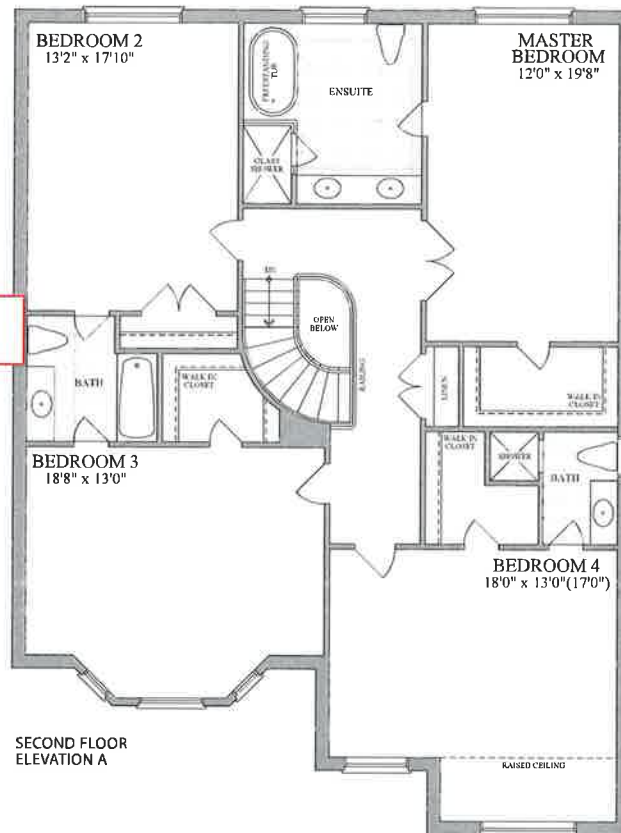


47'
DESIGNS

The nipissing / Elev. A & B
3210 sq.ft.

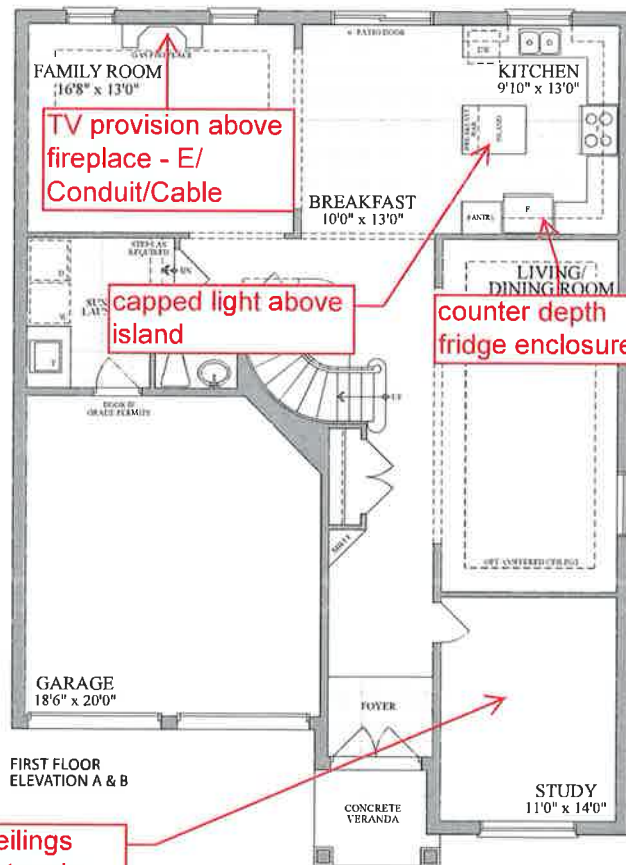

LOT 5-27, PH5, PE002

Purchaser: _____

Purchaser: Jaswantkthind
Jaswantkthind (May 3, 2022 23:34 EDT)



Plans and specifications are subject to change without notice. E. & O. E. Actual usable floor space may vary from the stated floor area. All renderings are artist's concept.