


38'
DESIGNS

The Temagami / Elev. A & B


includes 760 sq. ft. of finished area in lower level




delete
fireplace

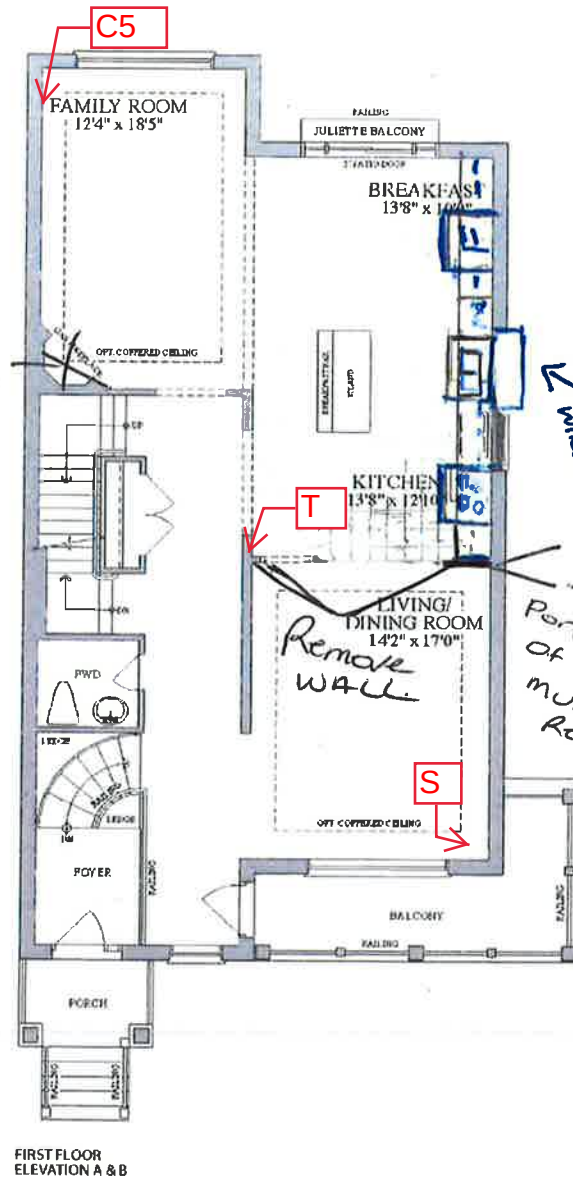


FIRST FLOOR
ELEVATION A & B

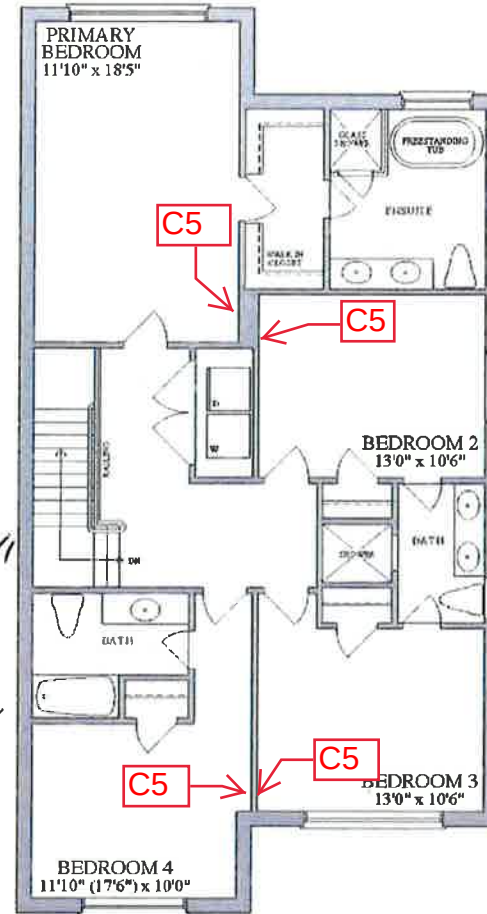

SECOND FLOOR
ELEVATION A

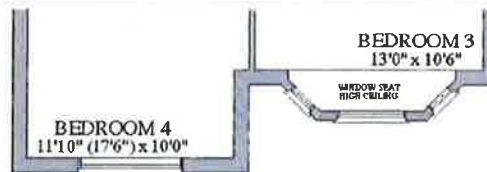

SECOND FLOOR
ELEVATION B

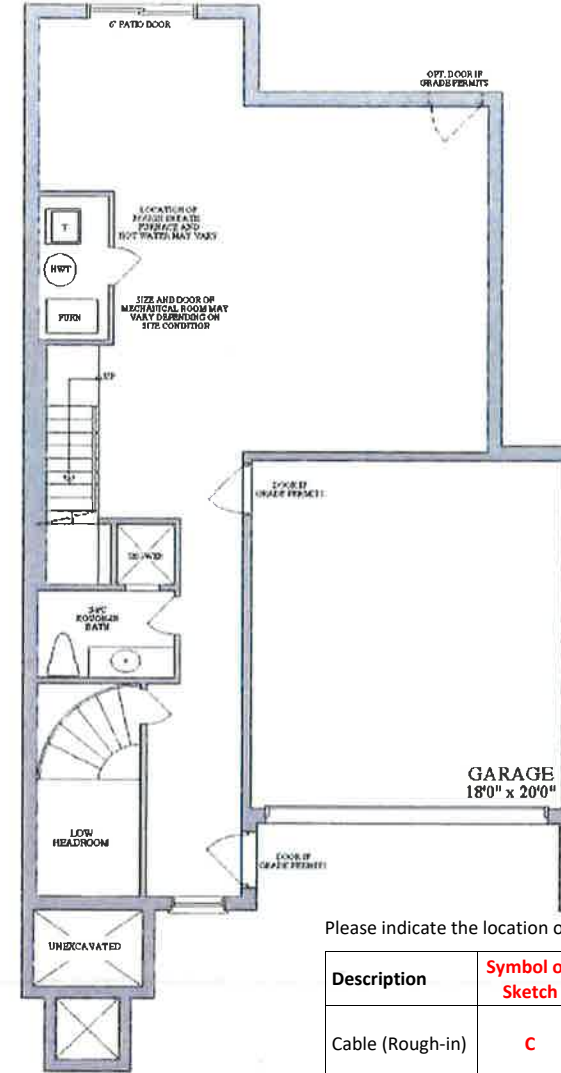

LOWER LEVEL
ELEVATION A & B
2 CAR GARAGE
3350 SQ. FT. INCLUDES 760 SQ. FT.
OF FINISHED AREA IN LOWER LEVEL



Please indicate the location of the rough-ins on your plan

Description	Symbol on Sketch	Standard Locations
Cable (Rough-in)	C	Family room Or Great Room, all bedrooms, Study/Den/Computer, (as per model)
Cat5	C5	A Cat5 wire can replace the rough-in cable at no additional cost.
Cat6	C6	Upgrade - \$50 per location
Telephone (Rough-in)	T	Kitchen and Primary Ensuite
Smart-Wire (Cat5)	S	Can be installed a Purchaser's desired location

LOT 5-73, PE003, SKETCH

Purchaser One (Phosho) (May 4, 2022 04:42 EDT)