



The **nipissing** / Elev. A & B
3210 sq.ft.

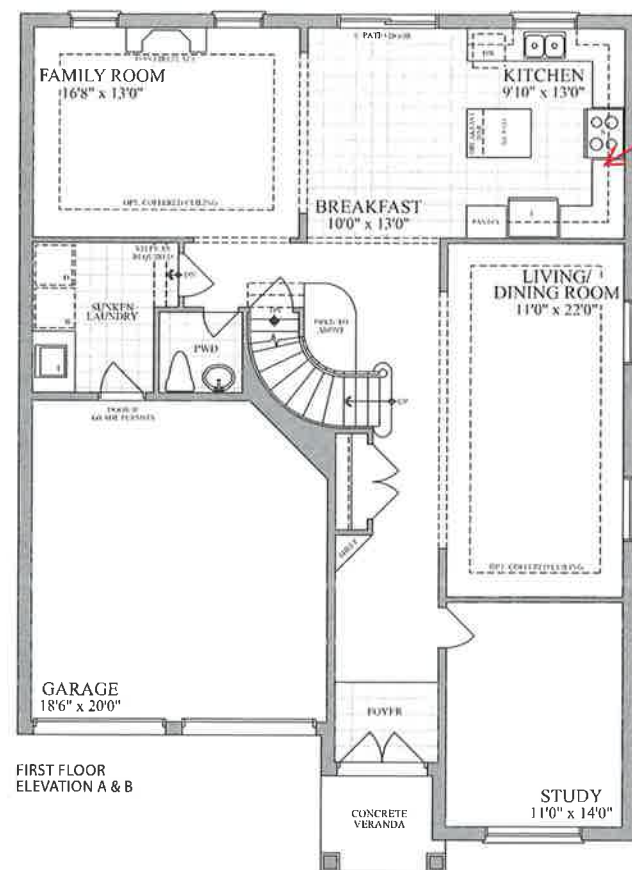


FIRST FLOOR
ELEVATION A & B

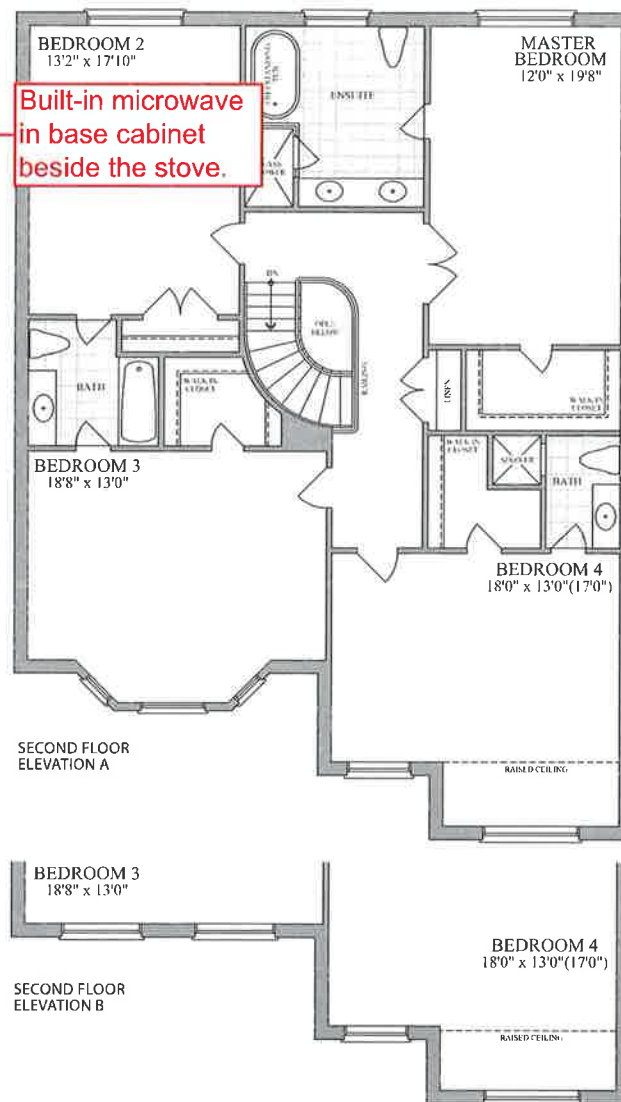


SECOND FLOOR
ELEVATION A

SECOND FLOOR
ELEVATION B

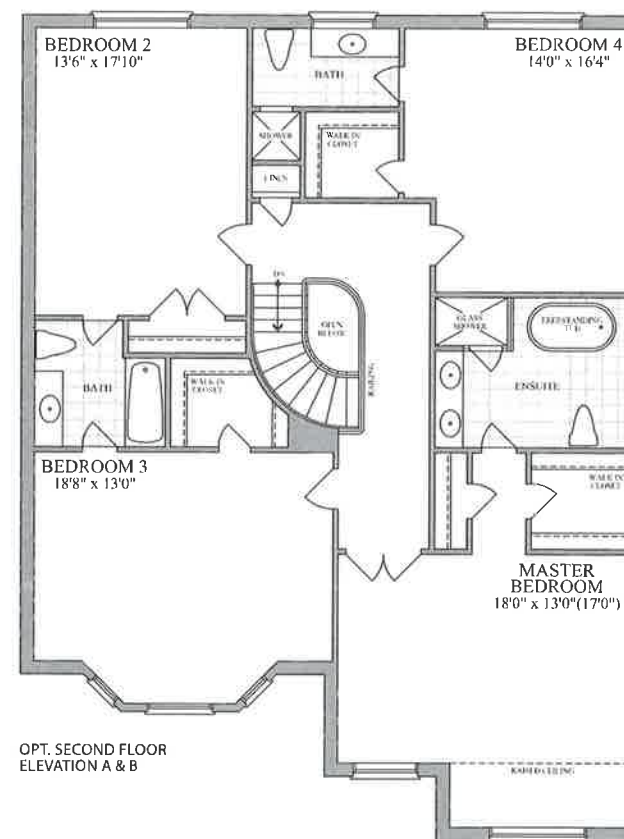

OPT. SECOND FLOOR
ELEVATION A & B

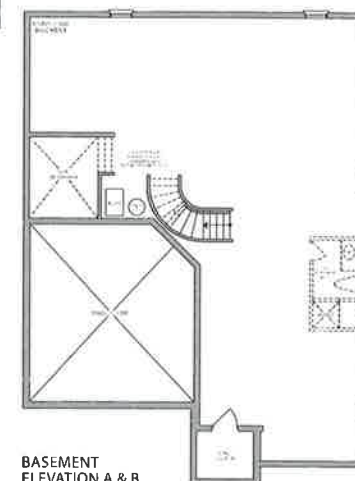

BASEMENT
ELEVATION A & B

LOT 5-61, PH5: hamid samadi
hamid samadi (May 11, 2022 09:43 EDT)

hamid samadi
hamid samadi (May 11, 2022 09:43 EDT)

Shaima samadi (May 10, 2022 21:46 EDT)



Plans and specifications are subject to change without notice. E. & O. E. Actual usable floor space may vary from the stated floor area. All renderings are artist's concept.