



47'
DESIGNS

The Kahshe / Elev. A & B
3000 sq.ft.

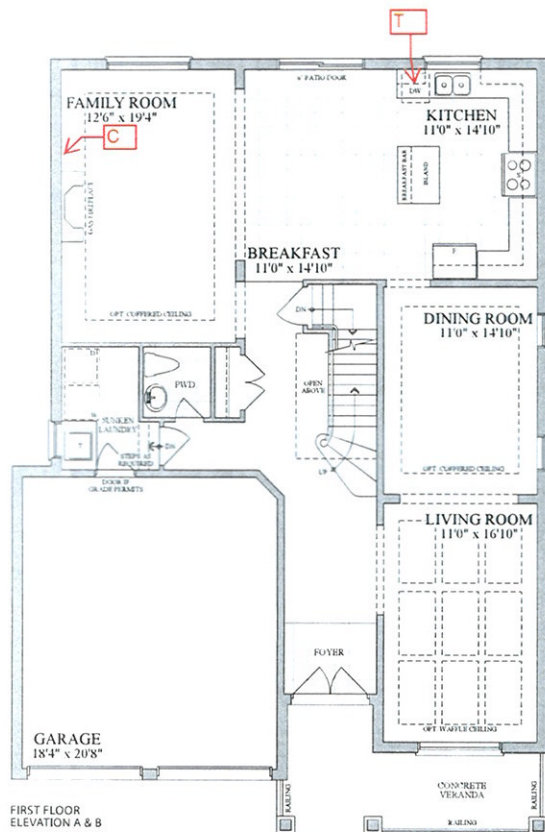

FIRST FLOOR
ELEVATION A & B

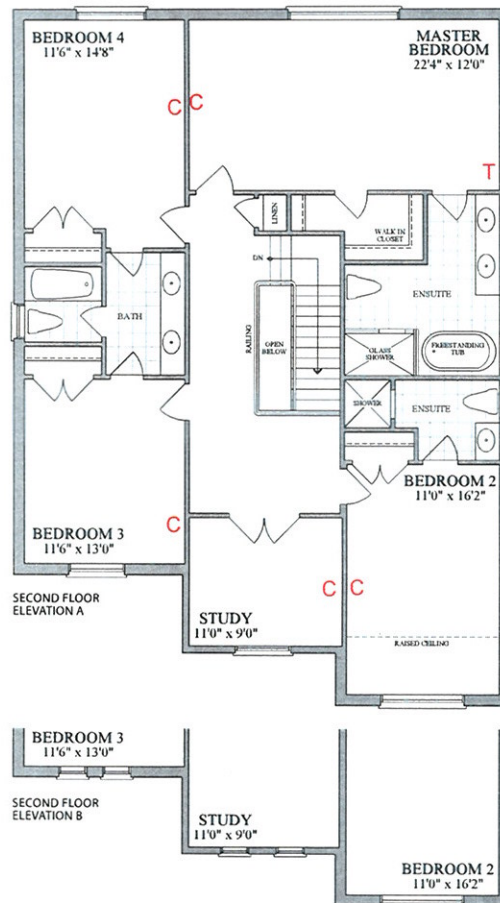

SECOND FLOOR
ELEVATION A

SECOND FLOOR
ELEVATION B



Please indicate the location of the rough-ins on your plan

Description	Symbol on Sketch	Standard Locations
Cable (Rough-in)	C	Family room Or Great Room, all bedrooms, Study/Den/Computer, (as per model)
Cat5	C5	A Cat5 wire can replace the rough-in cable at no additional cost.
Cat6	C6	Upgrade - \$50 per location
Telephone (Rough-in)	T	Kitchen and Primary Ensuite
Smart-Wire (Cat5)	S	Can be installed a Purchaser's desired location

LOT #: 5-75

PURCHASER:

PURCHASER: Jaswantkthind
(May 14, 2022 12:10 EDT)



Plans and specifications are subject to change without notice. E. & D. E. Actual usable floor space may vary from the stated floor area. All renderings are artist's concept.