

BLK 1-181, INNISFIL, PE004

*Handwritten signature*

Purchaser's Initial: PK

PK





Location for Microwave w/trim kit

shower seat to be next to tub

Life (1) Addition 1 Basement finished *Lorne*

BSMT. window to be approx 5' front the corner

The madawaska / Elev. A & B  
3190 sq.ft.

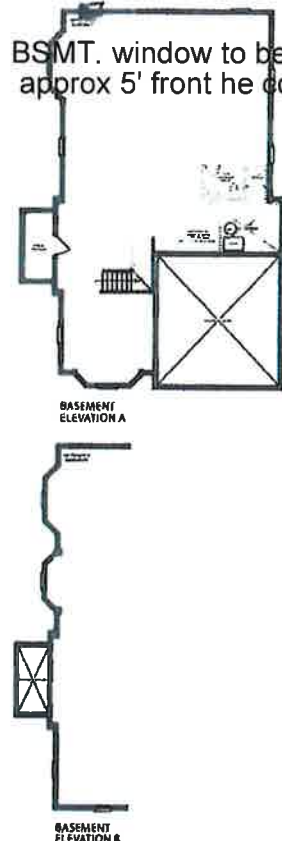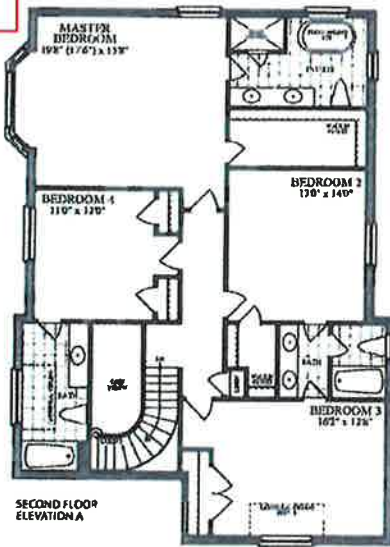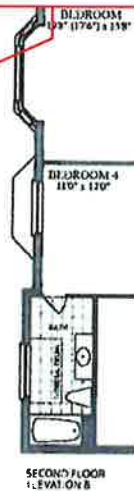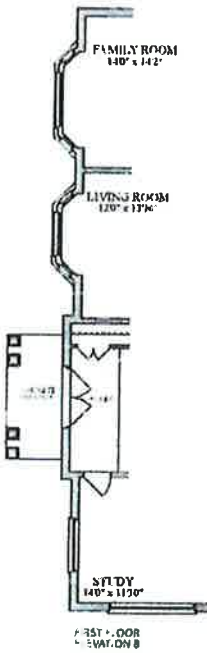

Plans and specifications are subject to change without notice. S. & G. T. Actual construction details may vary from the actual floor area. All dimensions are subject to change.