


Signature: Mikesell  
MICHAEL AGYEMANG-PREMEH (May 24, 2022 12:55 EDT)

Email: mikesellsgta@gmail.com

## LOT 1-135, PH1, CABLE LOCATIONS

47'  
DESIGNS

The Madawaska / Elev. A & B  
3190 sq.ft.

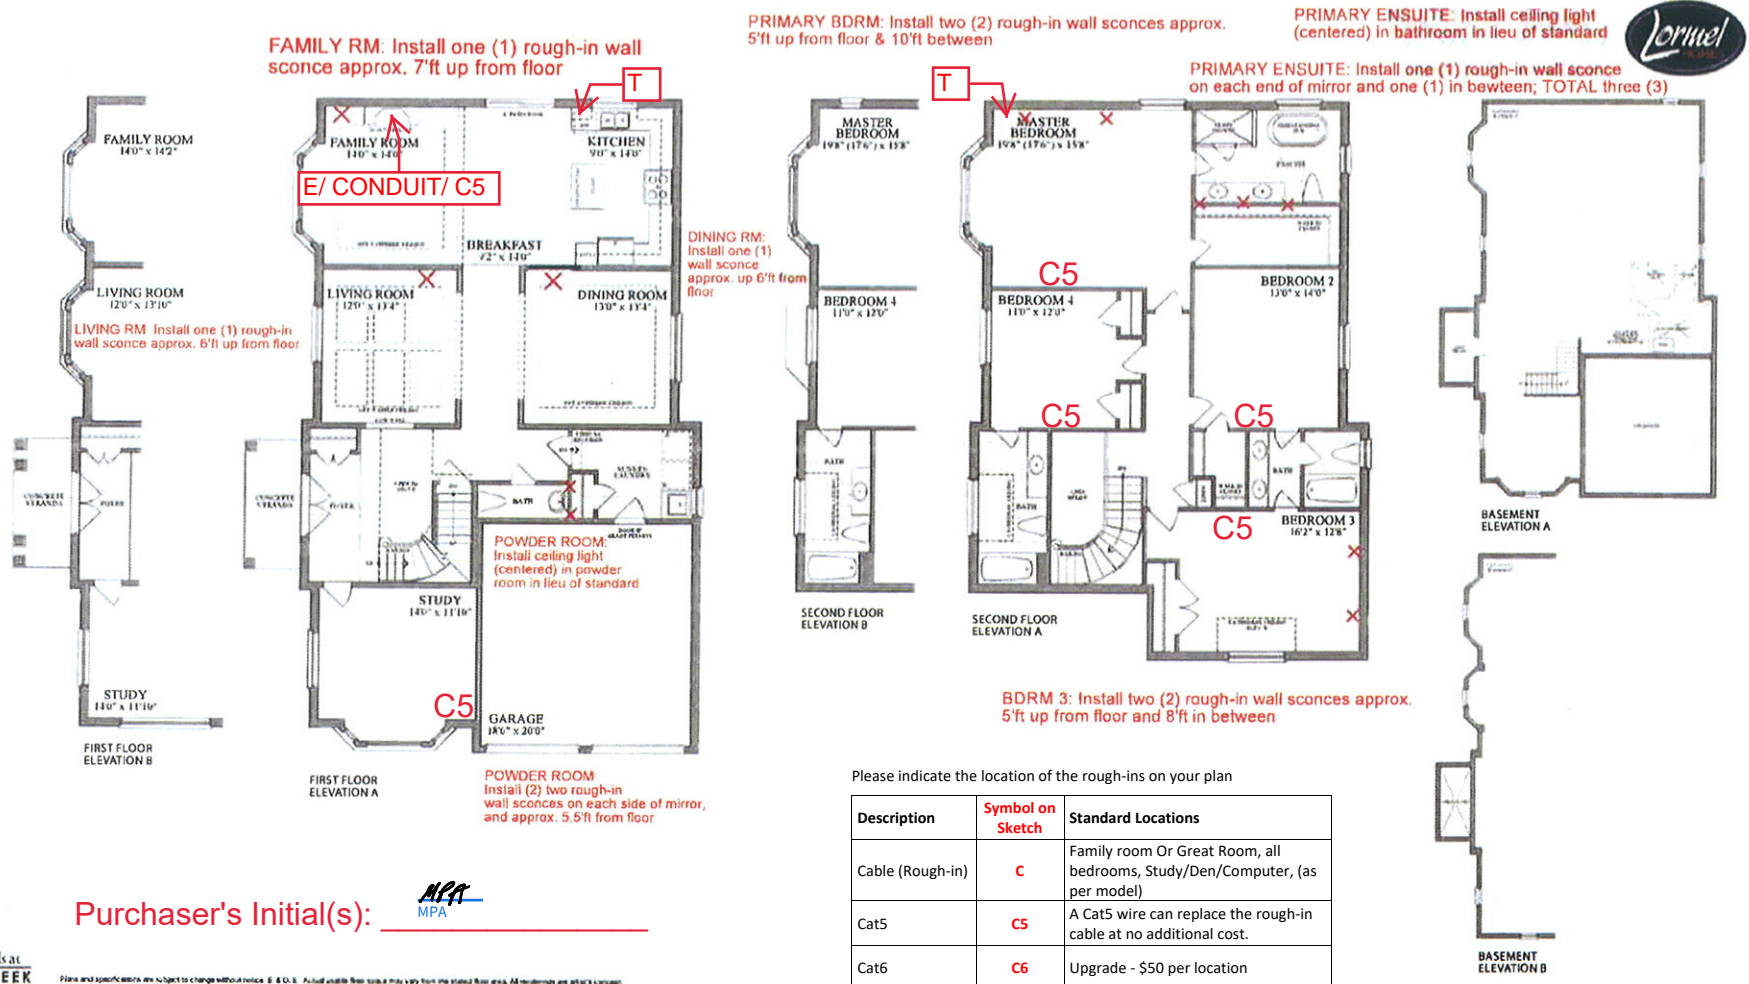

Please indicate the location of the rough-ins on your plan

Description	Symbol on Sketch	Standard Locations
Cable (Rough-in)	C	Family room Or Great Room, all bedrooms, Study/Den/Computer, (as per model)
Cat5	C5	A Cat5 wire can replace the rough-in cable at no additional cost.
Cat6	C6	Upgrade - \$50 per location
Telephone (Rough-in)	T	Kitchen and Primary Ensuite
Smart-Wire (Cat5)	S	Can be installed a Purchaser's desired location

# LOT 1-135, PH1, CABLE SKETCH

Final Audit Report

2022-05-24

Created:	2022-05-24
By:	The Design Studio, Lormel Homes (design@lormelhomes.com)
Status:	Signed
Transaction ID:	CBJCHBCAABAAuQC662MO5z5Y8pf2MvNpyCEUxOaPLmIK

## "LOT 1-135, PH1, CABLE SKETCH" History



Document created by The Design Studio, Lormel Homes (design@lormelhomes.com)

2022-05-24 - 4:19:08 PM GMT



Document emailed to MICHAEL AGYEMANG-PREMPEH (mikesellsgta@gmail.com) for signature

2022-05-24 - 4:20:08 PM GMT



Email viewed by MICHAEL AGYEMANG-PREMPEH (mikesellsgta@gmail.com)

2022-05-24 - 4:53:14 PM GMT



Document e-signed by MICHAEL AGYEMANG-PREMPEH (mikesellsgta@gmail.com)

Signature Date: 2022-05-24 - 4:55:56 PM GMT - Time Source: server



Agreement completed.

2022-05-24 - 4:55:56 PM GMT



Adobe Acrobat Sign