


47'  
DESIGNS

The Madawaska / Elev. A & B  
3190 sq.ft.

## LOT 1-135, INNISFIL, ELECTRICAL ONLY

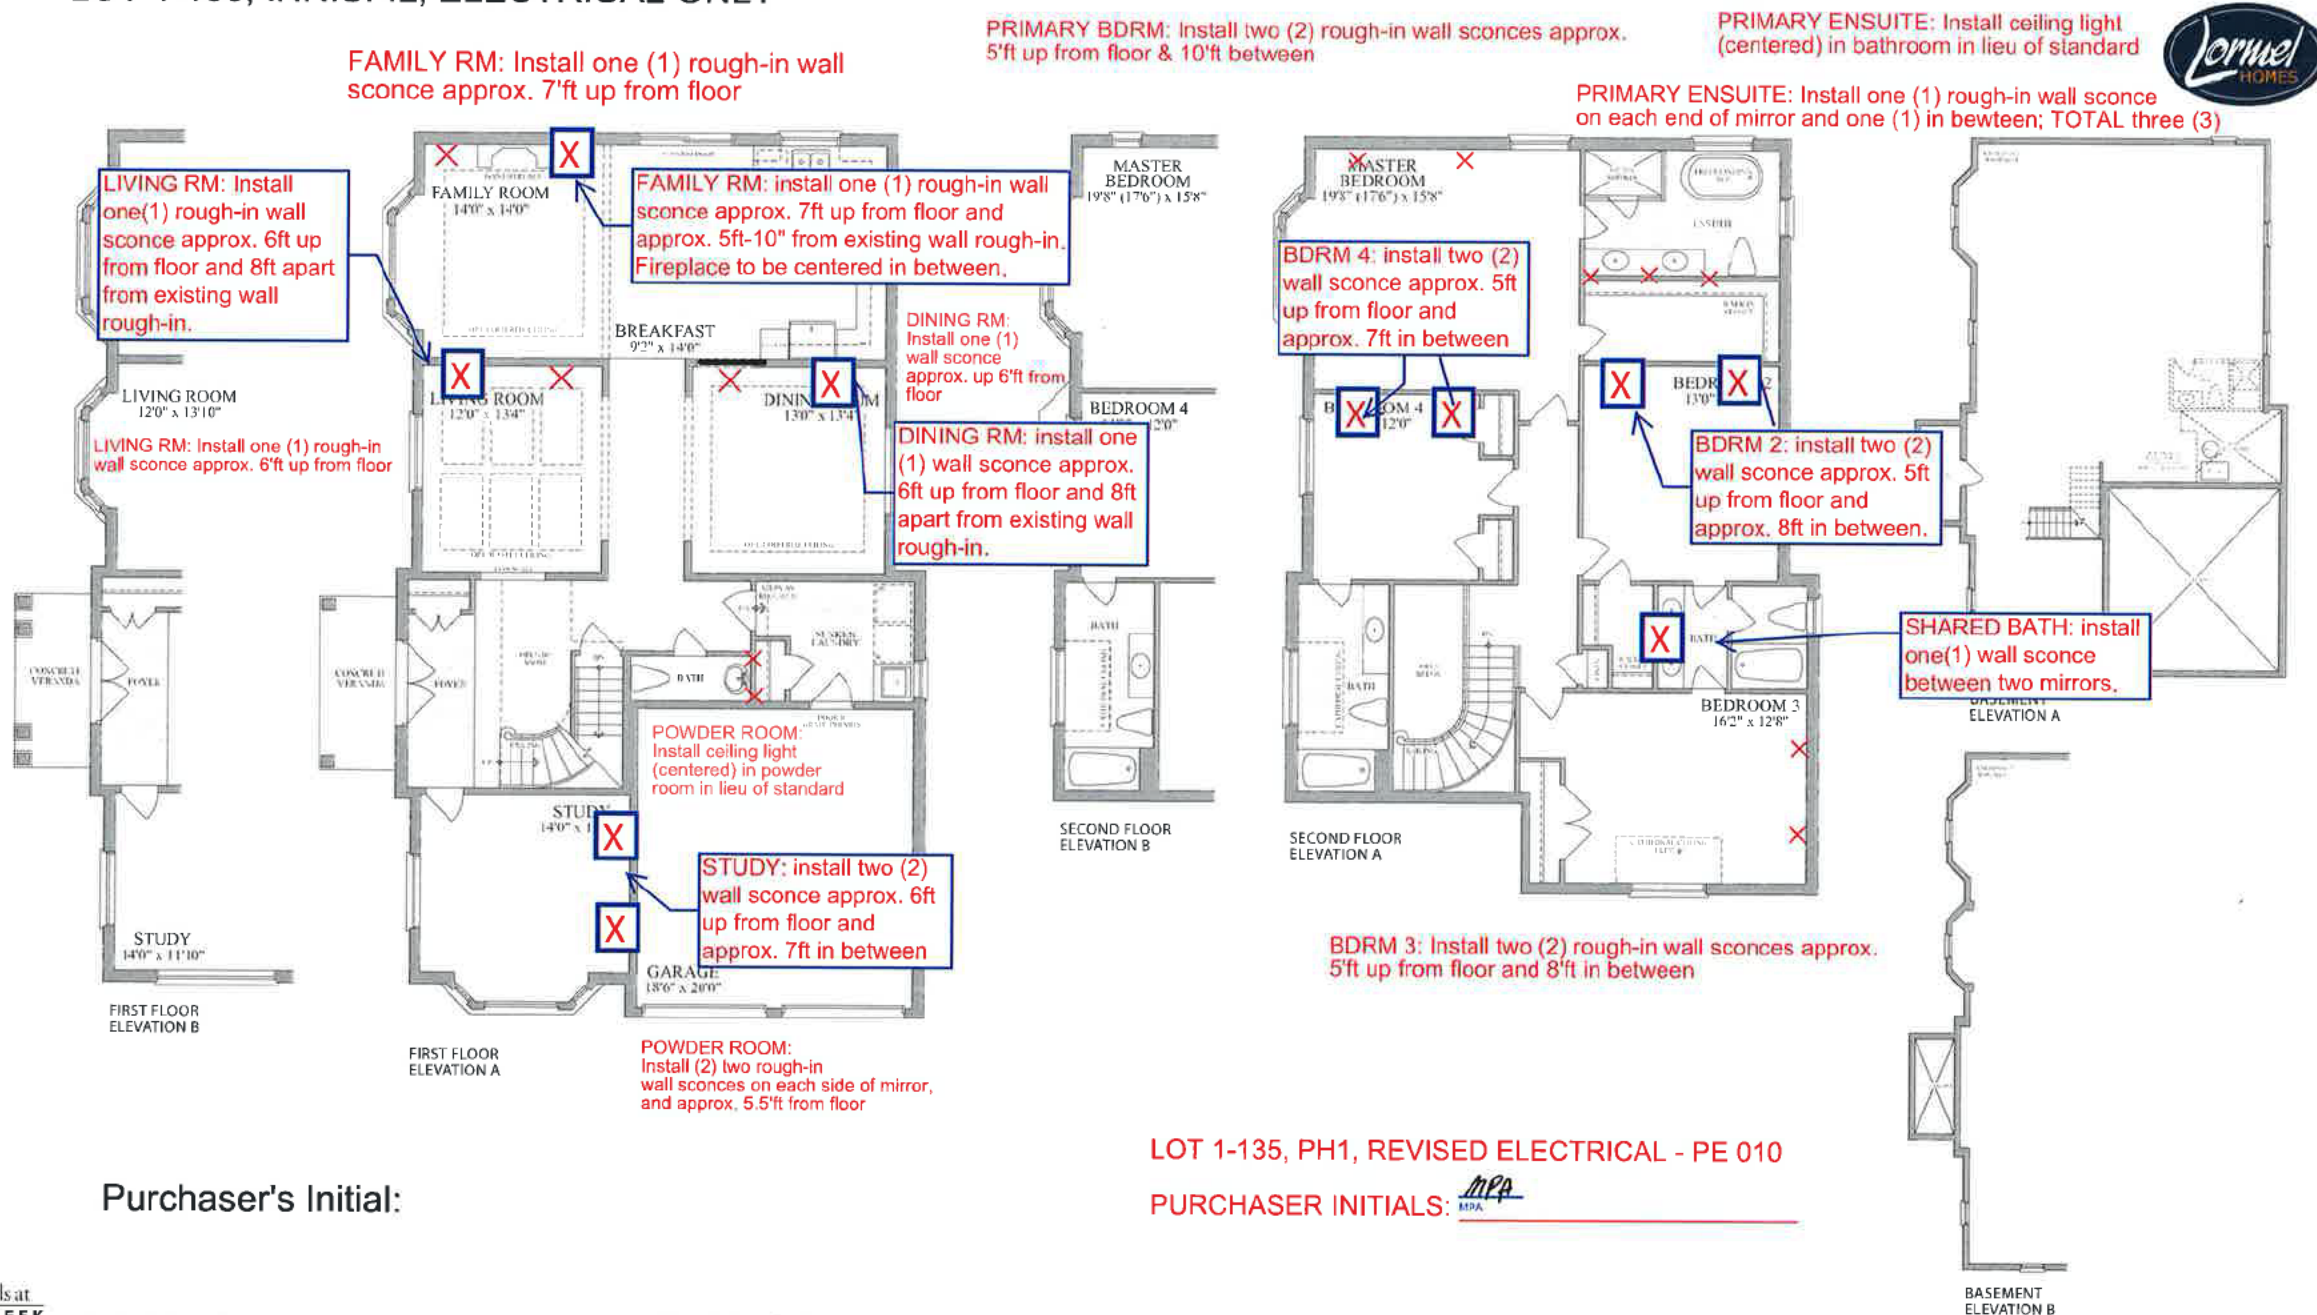

Purchaser's Initial: