
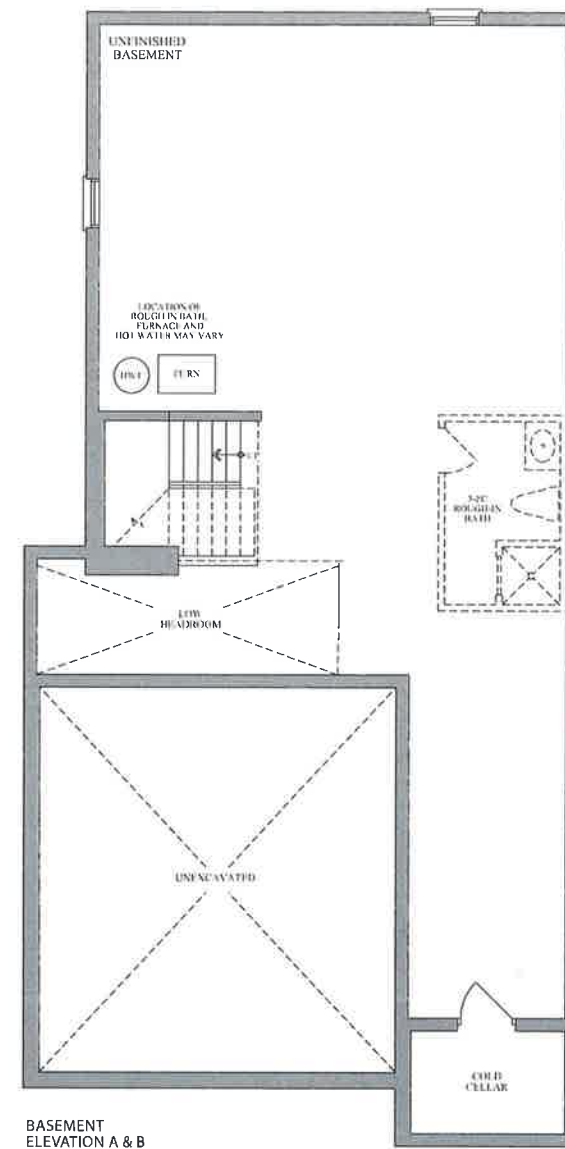
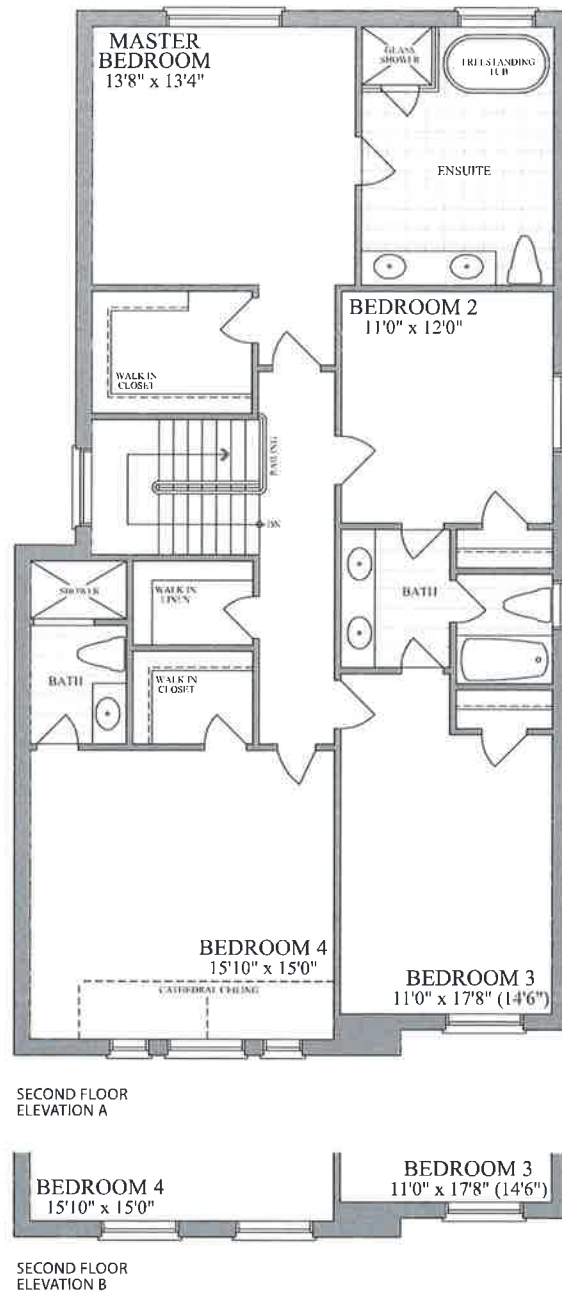


38'
DESIGNS

The Finlay / Elev. A & B
2515 sq.ft.

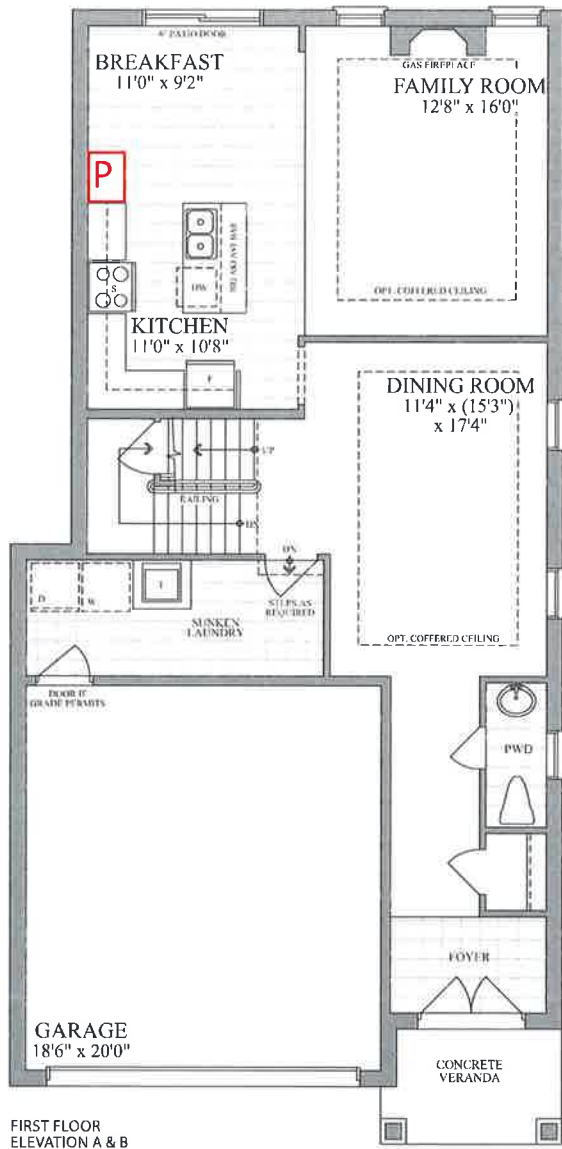

LOT 5-89, PH5, PE003

PURCHASER: Usman Ahmed (Jun 3, 2022 06:31 EDT)

PURCHASER: Maria gni (Jun 3, 2022 06:38 EDT)



Plans and specifications are subject to change without notice. E. & O. E. Actual usable floor space may vary from the stated floor area. All renderings are artist's concept.