


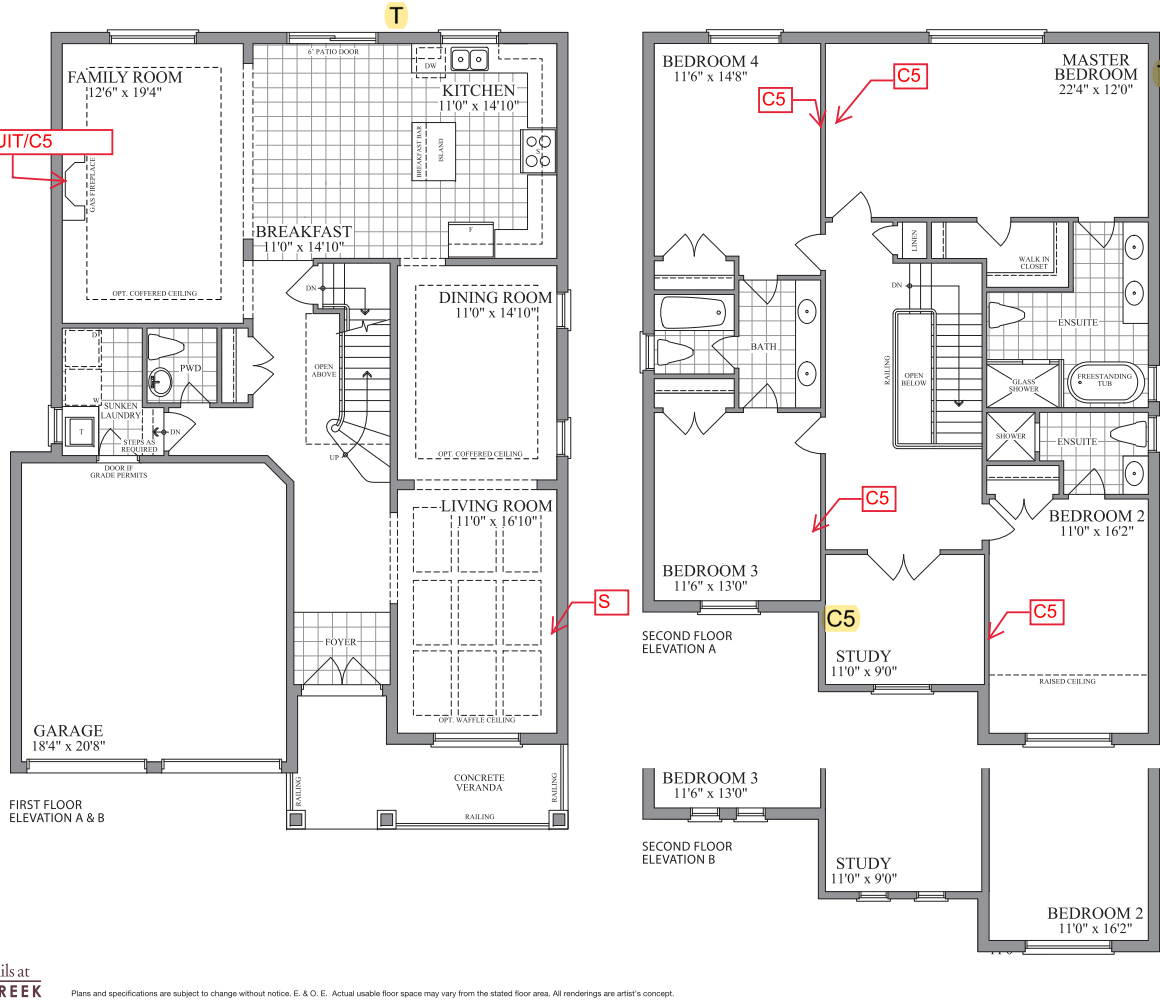

Please indicate the location of the rough-ins on your plan

Description	Symbol on Sketch	Standard Locations
Cable (Rough-in)	C	Family room Or Great Room, all bedrooms, Study/Den/Computer, (as per model)
Cat5	C5	A Cat5 wire can replace the rough-in cable at no additional cost.
Cat6	C6	Upgrade - \$50 per location
Telephone (Rough-in)	T	Kitchen and Primary Ensuite
Smart-Wire (Cat5)	S	Can be installed a Purchaser's desired location

RAISED CEILING

LOT #: 5-29.

PURCHASER: *[Signature]*

PURCHASER: *[Signature]*

LOT 5-29, PH5, CABLE LOCATIONS

PURCHASER: *[Signature]*
Nighat Khan (Jun 14, 2022 09:59 EDT)

PURCHASER: *[Signature]*
Hidayat Khan (Jun 14, 2022 10:04 EDT)

BEDROOM 2
11'0" x 16'2"