




FIRST FLOOR  
ELEVATION A & B

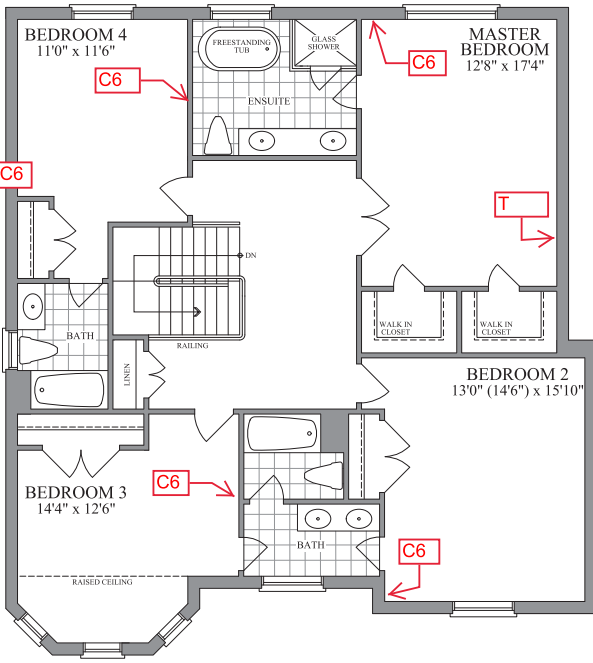

SECOND FLOOR  
ELEVATION A

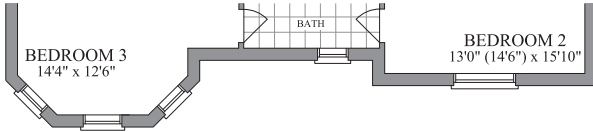

SECOND FLOOR  
ELEVATION B

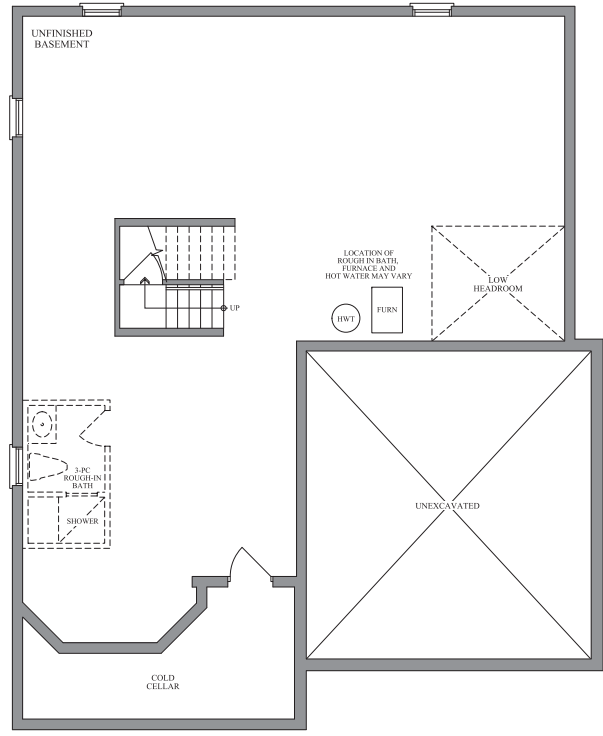

BASEMENT  
ELEVATION A & B

re-locate standard fireplace to middle of family room

E/CONDUIT/C6

LOT 5-28, PH5, PE004

PURCHASER: Pranay Sharma (Jun 10, 2022 18:54 EDT)

PURCHASER: Pranay Sharma (Jun 11, 2022 10:13 EDT)