



38'
DESIGNS

The Finlay / Elev. A & B
2515 sq.ft.

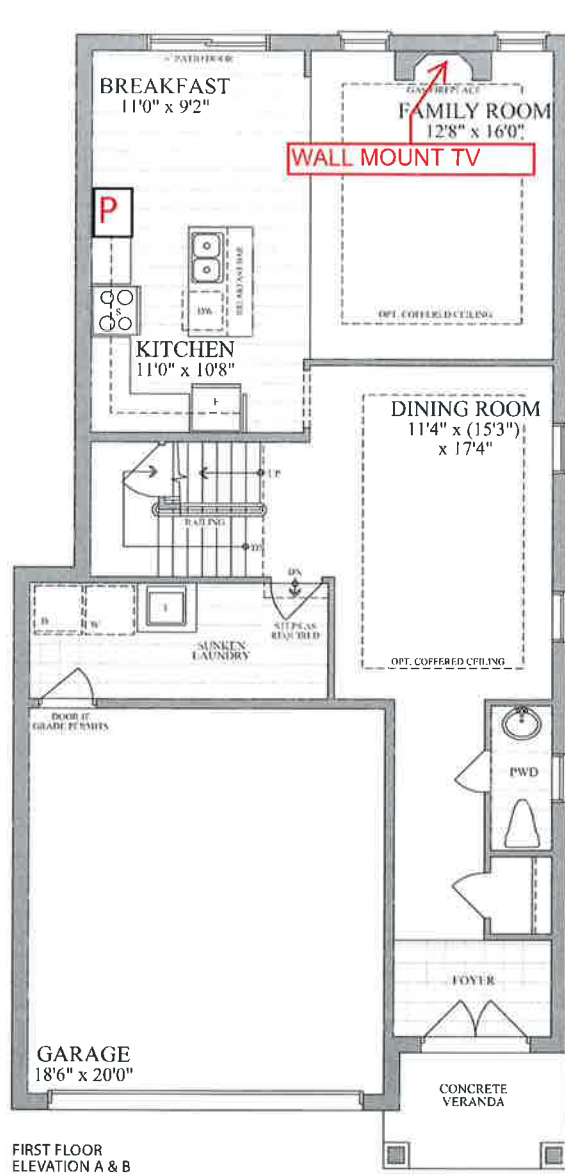


FIRST FLOOR
ELEVATION A & B

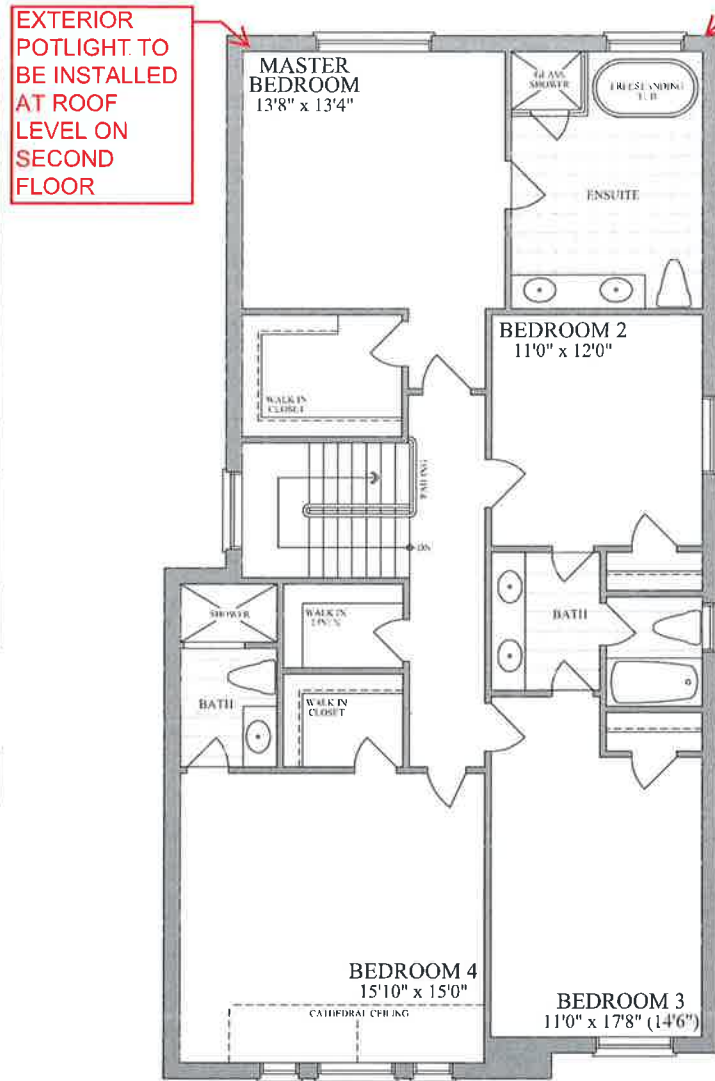

SECOND FLOOR
ELEVATION A



SECOND FLOOR
ELEVATION B

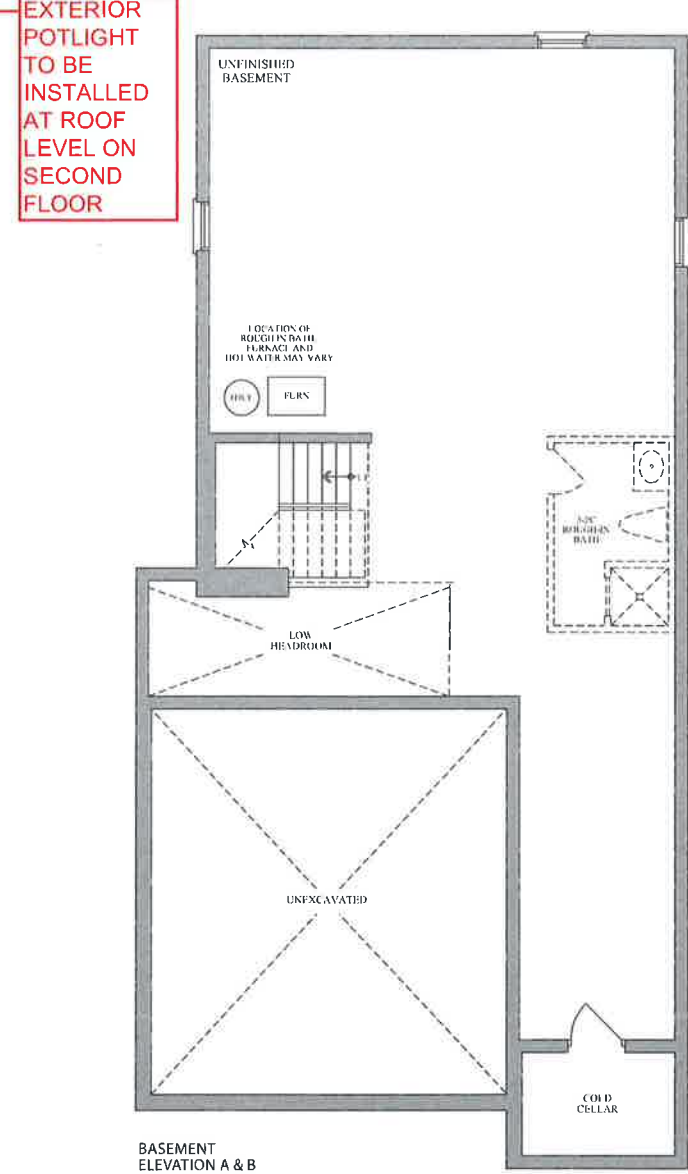

BASEMENT
ELEVATION A & B

LOT 5-36- PE002

PURCHASER: Sohail Munir
Sohail Munir (May 31, 2022 17:27 EDT)



Plans and specifications are subject to change without notice. E. & O. E. Actual usable floor space may vary from the stated floor area. All renderings are artist's concept.